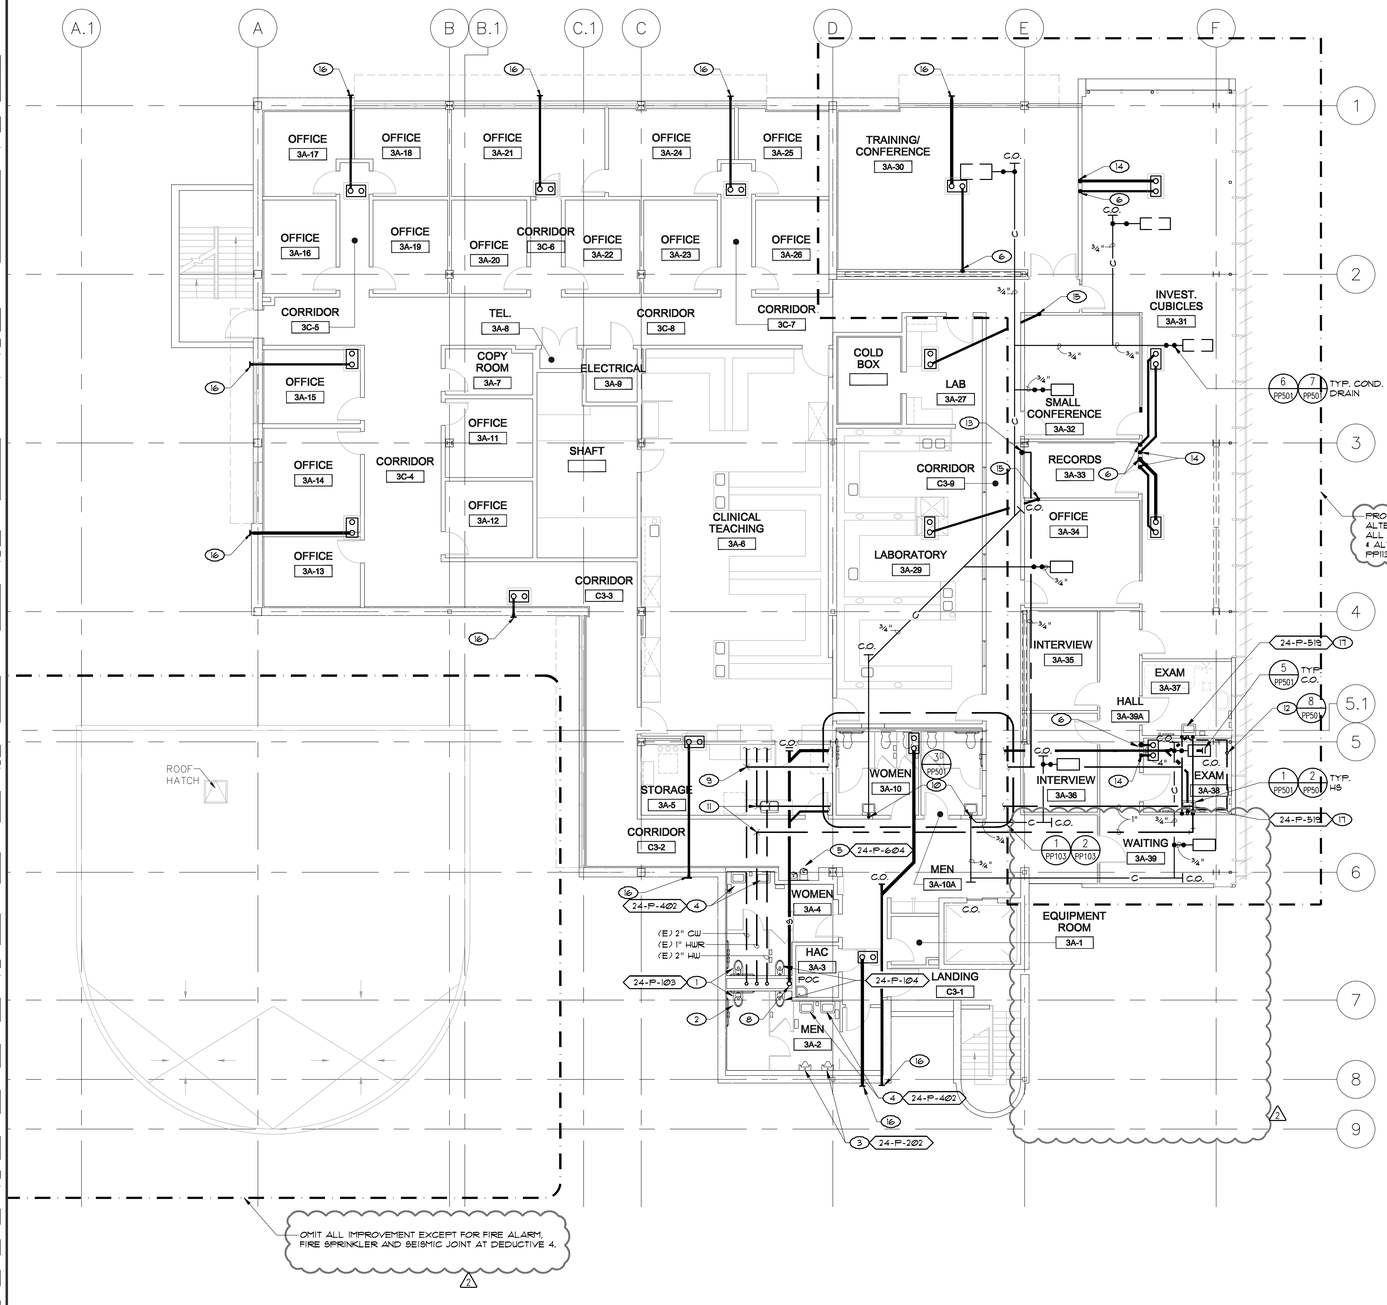

1 THIRD FLOOR PLUMBING REMODEL PLAN
SCALE: 1/8" = 1'-0"

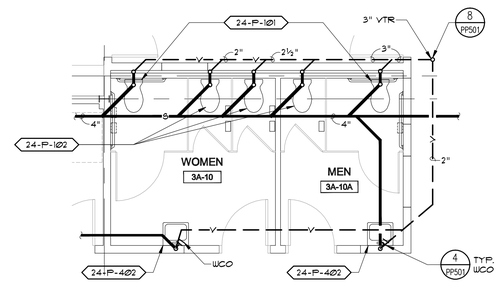

2 ENLARGED RESTROOM PLAN - WASTE AND VENT
SCALE: 1/4" = 1'-0"

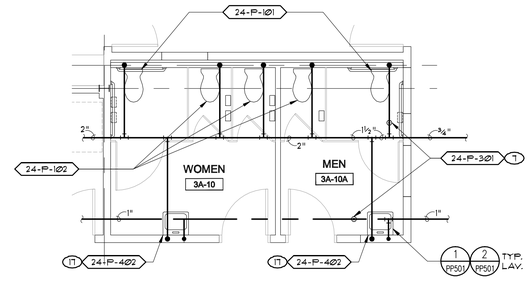

3 ENLARGED RESTROOM PLAN - COLD AND HOT WATER
SCALE: 1/4" = 1'-0"

KEY NOTES

1. REPLACE (E) WATER CLOSET WITH RETROFIT HEIGHT WALL MOUNT WATER CLOSET.
2. REROUTE WATER CONNECTION TO OPPOSITE SIDE OF WATER CLOSET. ROTATE FLUSH VALVE AROUND 180° SO VALVE HANDLE IS AT THE WIDE SIDE OF STALL.
3. REPLACE (E) WALL MOUNT URINAL WITH UFAS COMPLIANT MODEL AND PROVIDE ALL NEW ROUGH-IN.
4. REPLACE (E) WALL MOUNT LAVATORY WITH UFAS COMPLIANT MODEL AND PROVIDE ALL NEW ROUGH-IN. PROVIDE AND INSTALL (TRUEBRO HANDI LAV-GUARD #Ø2W OR EQUAL) INSULATED RUBBER WRAP ON P-TRAP AND ANGLE STOP ASSEMBLIES UNDER LAVATORY.
5. REPLACE (E) SINGLE HEIGHT ELECTRIC DRINKING FOUNTAIN WITH DUAL HEIGHT REFRIGERATED DRINKING FOUNTAIN.
6. 3" ROOF DRAIN DROP DOWN IN WALL FROM NEW THIRD FLOOR ADDITIONAL ROOF DRAIN. SEE SHEET PP1Ø2 FOR CONTINUATION.
7. PROVIDE WATER HAMMER ARRESTOR (WHA-1) AT END OF CW AND HW PIPE RUNS.
8. FOC AT (E) 4" SOIL DROP IN PLUMBING CHASE AT SECOND FLOOR ATTIC.
9. FOC AT (E) 2" PIPE IN THIRD FLOOR ATTIC.
10. ¾" CONDENSATE DRAIN IN ATTIC, SLOPE DOWN ⅛" PER FOOT, DROP DOWN INSIDE WALL AND CONNECT TO TAILPIECE AT LAVATORY.
11. FOC AT (E) 1" HWR PIPE IN THIRD FLOOR ATTIC. REMOVE SECTION OF PIPE BETWEEN FOC'S SO HW REROUTES TO EXAM ROOM AND MAINTAINS CONTINUOUS LOOP.
12. 2" VTR, ROUTE 1½" VENT DOWN FROM VTR TO EACH HS-1.
13. ¾" CW UP THRU ROOF TO HOSE BIBB.
14. 3" OD DROP DOWN IN WALL FROM NEW THIRD FLOOR ADDITIONAL ROOF DRAIN, SEE SHEET PP1Ø2 FOR CONTINUATION.
15. 3" OD DROP DOWN IN WALL FROM THIRD FLOOR REPLACEMENT ROOF DRAIN, SEE SHEET PP1Ø2 FOR CONTINUATION.
16. 3" OD, RUN IN THIRD FLOOR ATTIC TO ¼" BEYOND SURFACE OF EXTERIOR WALL.
17. PROVIDE AND INSTALL (TRUEBRO HANDI LAV-GUARD #Ø2W OR EQUAL) INSULATED RUBBER WRAP ON P-TRAP AND ANGLE STOP ASSEMBLIES UNDER NEW LAVATORY.

PLUMBING FIXTURE NOTE

REFER TO SHEET PP6Ø0 FOR PLUMBING FIXTURE SCHEDULE. ALL NEW FIXTURES SHALL HAVE NEW ROUGH-IN CONNECTED TO (E) PIPES THRU WALL.

Revisions:	Date
2	7-25-2013
1	7-22-2013

CONSULTANTS:

REGISTERED PROFESSIONAL ENGINEER — CORREY W. LONGLOW — NO. 33380 — EXP. 6-30-14 — MECHANICAL — STATE OF CALIFORNIA

LP Consulting Engineers, Inc.
895 W. Ashlan Ave, Suite 101 Clovis, CA 93612
p 559-349-2130 - f 559-349-2131
www.lpengineers.com
Job #: 10-1696

LICENSED ARCHITECT — RICHARD G. HARRIS — NO. C-21897 — REN. 07-31-15 — STATE OF CALIFORNIA

ARCHITECT/ENGINEERS:

HMC Architects
1827 E. Fir Avenue, Studio 103 / Fresno, CA 93720
T 559 322 2444 / www.hmcarchitects.com

Drawing Title: THIRD FLOOR PLUMBING REMODEL PLAN

Approved: Project Director

Project Title: BUILDING 24 SEISMIC CORRECTION AND ADDITION

Location: VAMC FRESNO, CA

Date: 7/26/2013 | Checked: K.K. | Drawn: D.N.

Project Number: 570-215

Building Number: 24

Drawing Number: PP103

Dwg. 103 of 176

Office of Construction and Facilities Management

Department of Veterans Affairs

VA FORM 08-6231