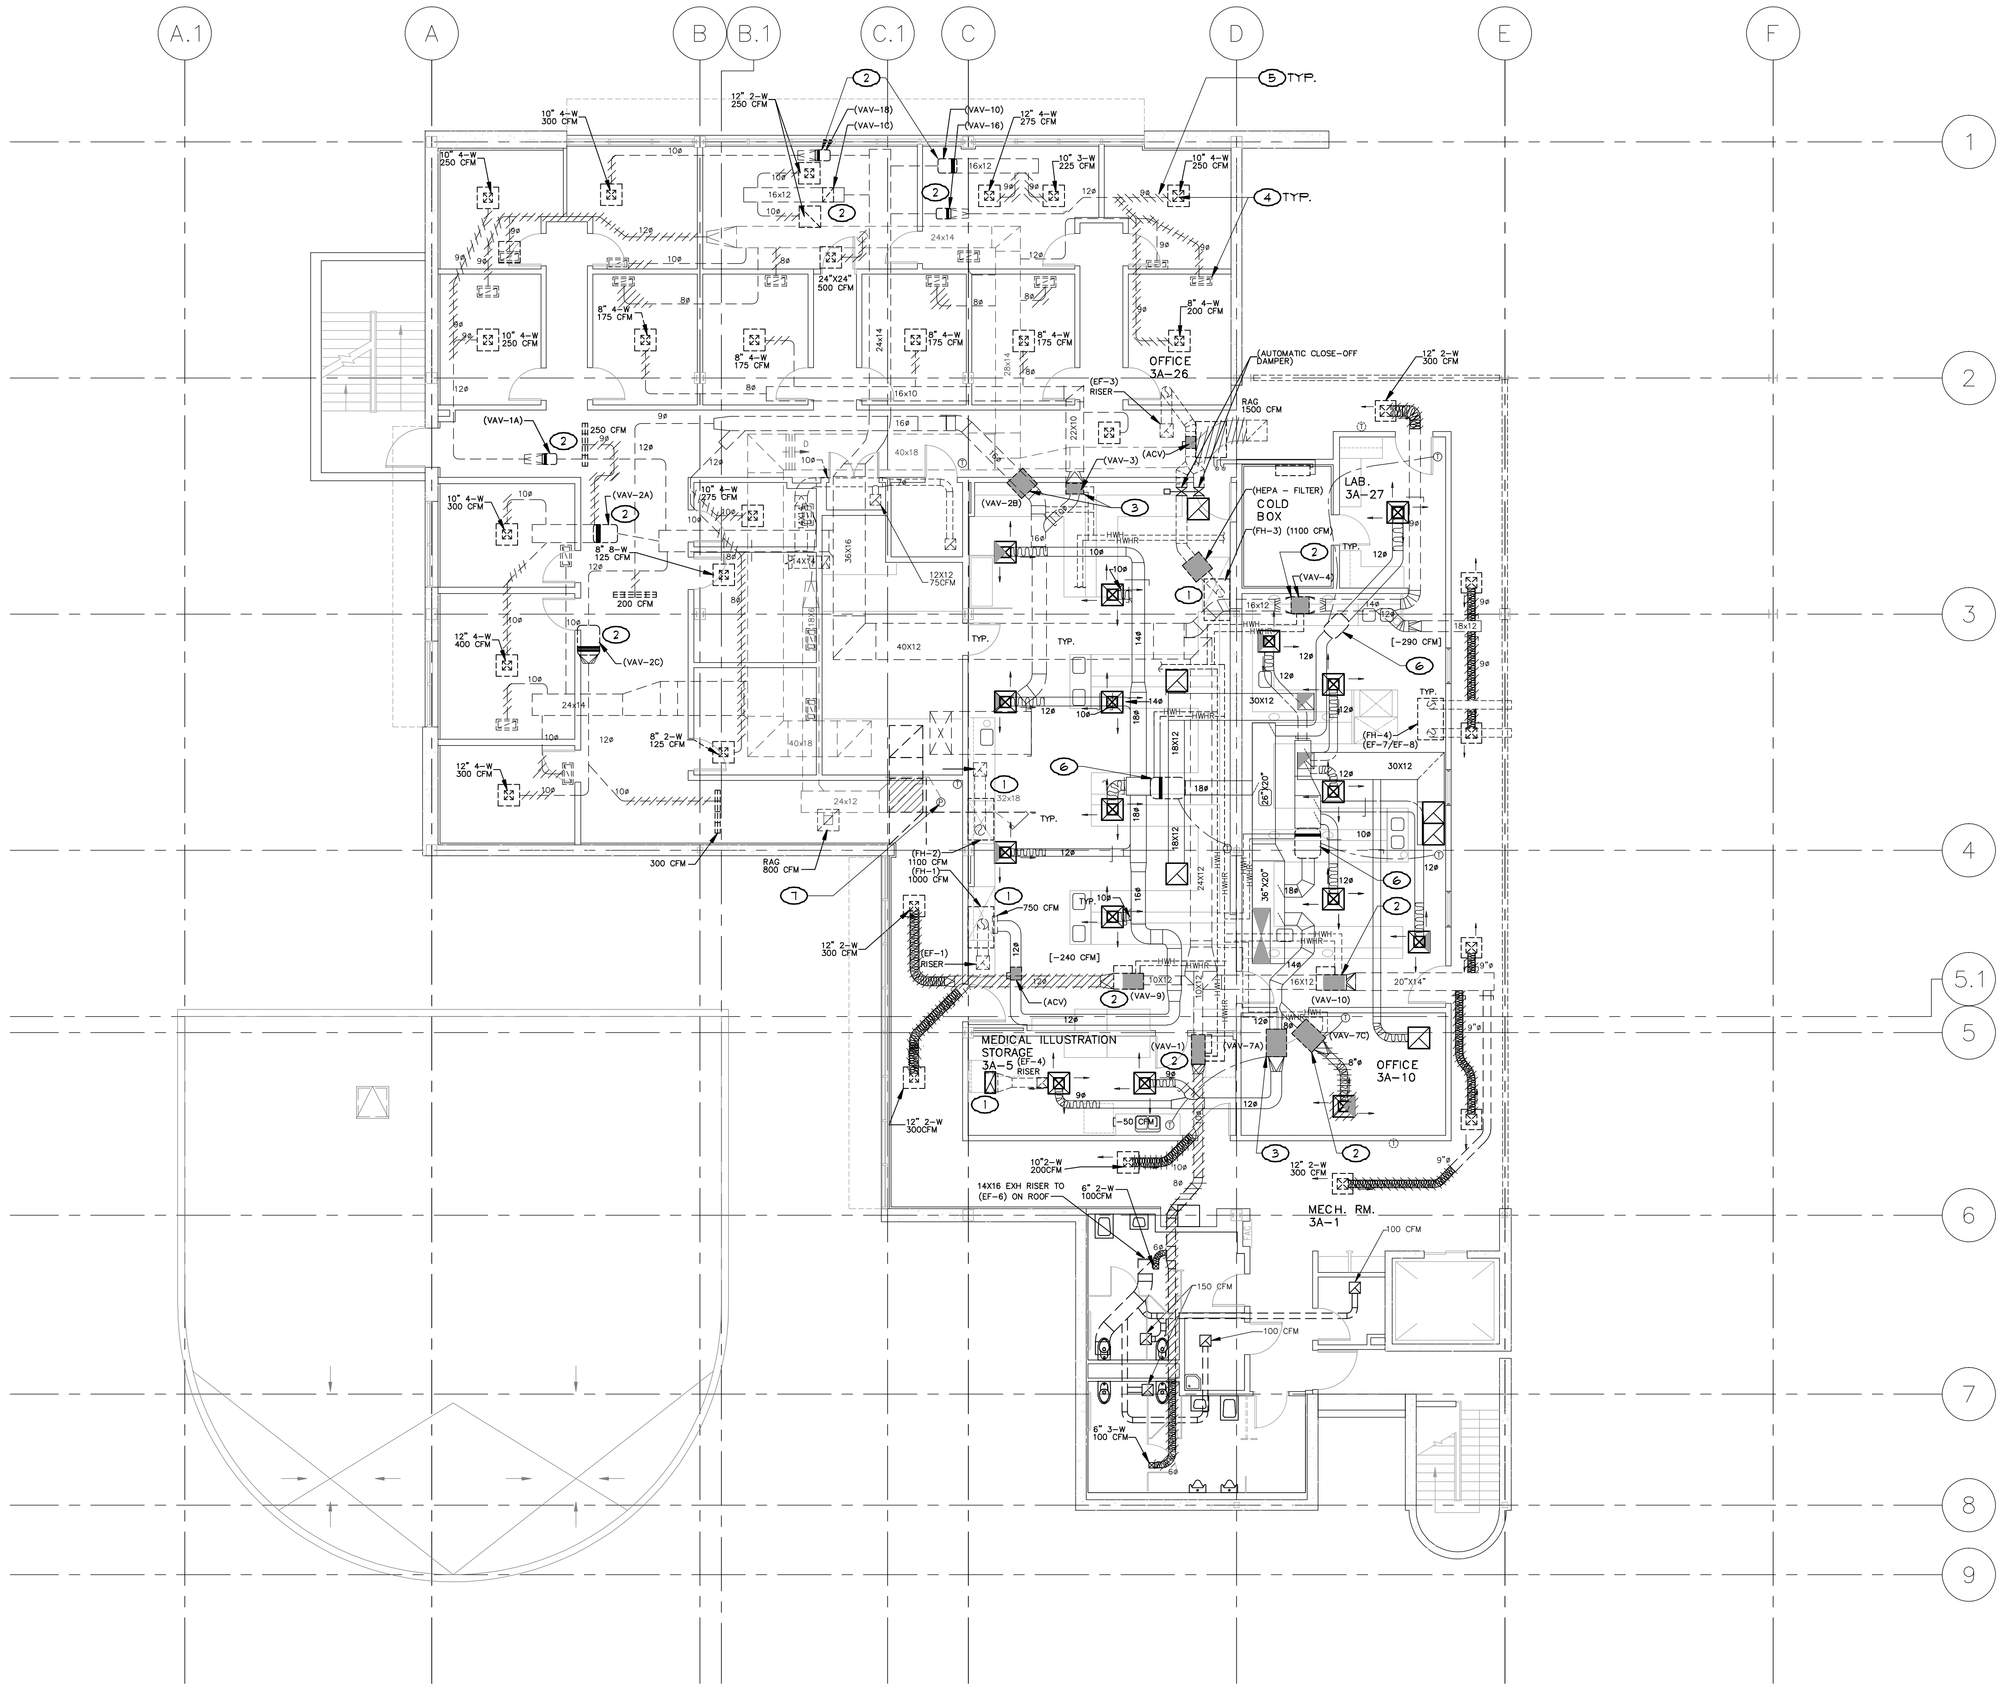


## KEY NOTES

1. (E) FUME HOOD TO REMAIN.
2. REMOVE (E) VAV BOX WITH REHEAT COIL.
3. REMOVE (E) VAV BOX.
4. REMOVE (E) CEILING GRILLE.
5. REMOVE (E) DUCT SHOWN HATCHED. ALL DUCTWORK TO REMAIN SHALL BE CLEANED PER SPEC. SECT. 23 31 00. SEE DEDUCT ALTERNATE #0 NOTES ON SHEET MH600. (2)
6. (E) VAV BOX TO REMAIN.
7. (E) MAGNEHELIC PRESSURE GAGE AND SENSOR TUBING IN DUCT TO REMAIN. THIS IS TYPICAL AT ALL RETURN AND EXHAUST DUCT PENETRATIONS THRU CORRIDOR WALL, NOT ALL ARE SHOWN ON PLAN.

1 THIRD FLOOR MECHANICAL DEMOLITION PLAN
SCALE: 1/8" = 1'-0"

| Revisions: | Date |
|---|---|
| 2 | 7-25-2013 |
| 1 | 7-22-2013 |

CONSULTANTS:

REGISTERED PROFESSIONAL ENGINEER SUNEET M. LENGERJAN NO. 33380 EXP. 6-30-14 MECHANICAL STATE OF CALIFORNIA

LP Consulting Engineers, Inc.
895 W. Ashlan Ave, Suite 101 Clovis, CA 93612
p 559-348-2130 - f 559-348-2131
www.lpengineers.com
Job #: 10-1686

LICENSED ARCHITECT SUNIL K. GRUNDY NO. C-14597 REN. 07-31-15 STATE OF CALIFORNIA

ARCHITECT/ENGINEERS:

HMC Architects
1827 E. Fir Avenue, Studio 103 / Fresno, CA 93720
T 559 322 2444 / www.hmcarchitects.com

| | |
|---|---|
| Drawing Title | THIRD FLOOR MECHANICAL DEMOLITION PLAN |
| Approved: Project Director | |
| Project Title | BUILDING 24 SEISMIC CORRECTION AND ADDITION |
| Location | VAMC FRESNO, CA |
| Date | 7/26/2013 |
| Checked | K.K. |
| Drawn | D.N. |
| Project Number | 570-215 |
| Building Number | 24 |
| Drawing Number | MD103 |
| | Dwg. 127 of 176 |

Office of Construction and Facilities Management

Department of Veterans Affairs

VA FORM 08-6231