


HW BYPASS WILL
NEED A KEYLESS
IN LINE VALVE
WITH A SCREW
CAP

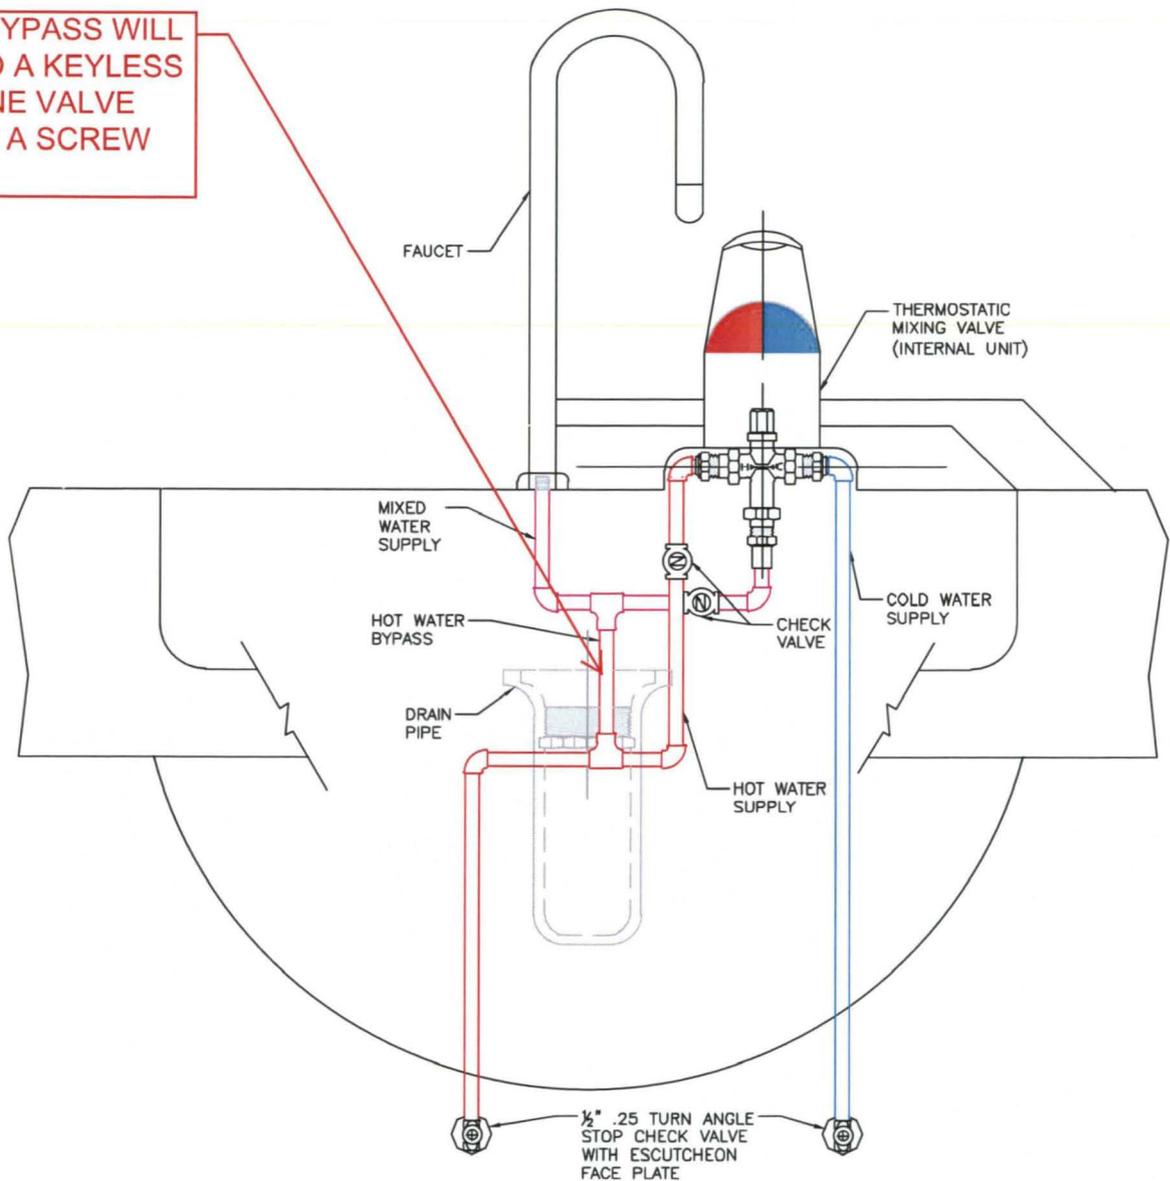

NOTES:

1. INSULATE ALL PIPING AND VALVES THAT ARE EXPOSED DURING CONSTRUCTION.
2. FIELD VERIFY THAT ALL PLUMBING WORK IS SECURE AND RIGID TO BLOCKING SUBSTRATE.
3. REFER TO PLUMBING SYSTEMS MANUAL AND SCHEDULE TO COORDINATE SYSTEMS INSTALLATION WITH EACH LOCATION THAT REQUIRES A SPECIALIZED APPLICATION.

1. CHANGED PLUMBING LINE-UP.

4-1-2013

**Office of
Facilities
Management**



Approved: Director, VA Pittsburgh Healthcare System

Approved: Chief Operating Officer

Approved: Vice President, Facilities Management

Approved: Manager, Projects Section

Drawing Title
**SINK CONTROL AND
BYPASS DETAIL**

Approved: VISION 4, Safety and Fire Protection Engineer

Approved: Site Manager

Project Title
**PLUMBING UPGRADES
PROJECT**

Building No.
#1

Scale
NTS

Drawn
DM

Location
VA PITTSBURGH HEALTHCARE SYSTEM
3101 B. W. WILSON DRIVE
PITTSBURGH, PA 15116

Date
MAR. 27, 2013


Project No.

DRAWING NO.

SK 6

Drawg 1 of 1

**Veterans
Affairs**

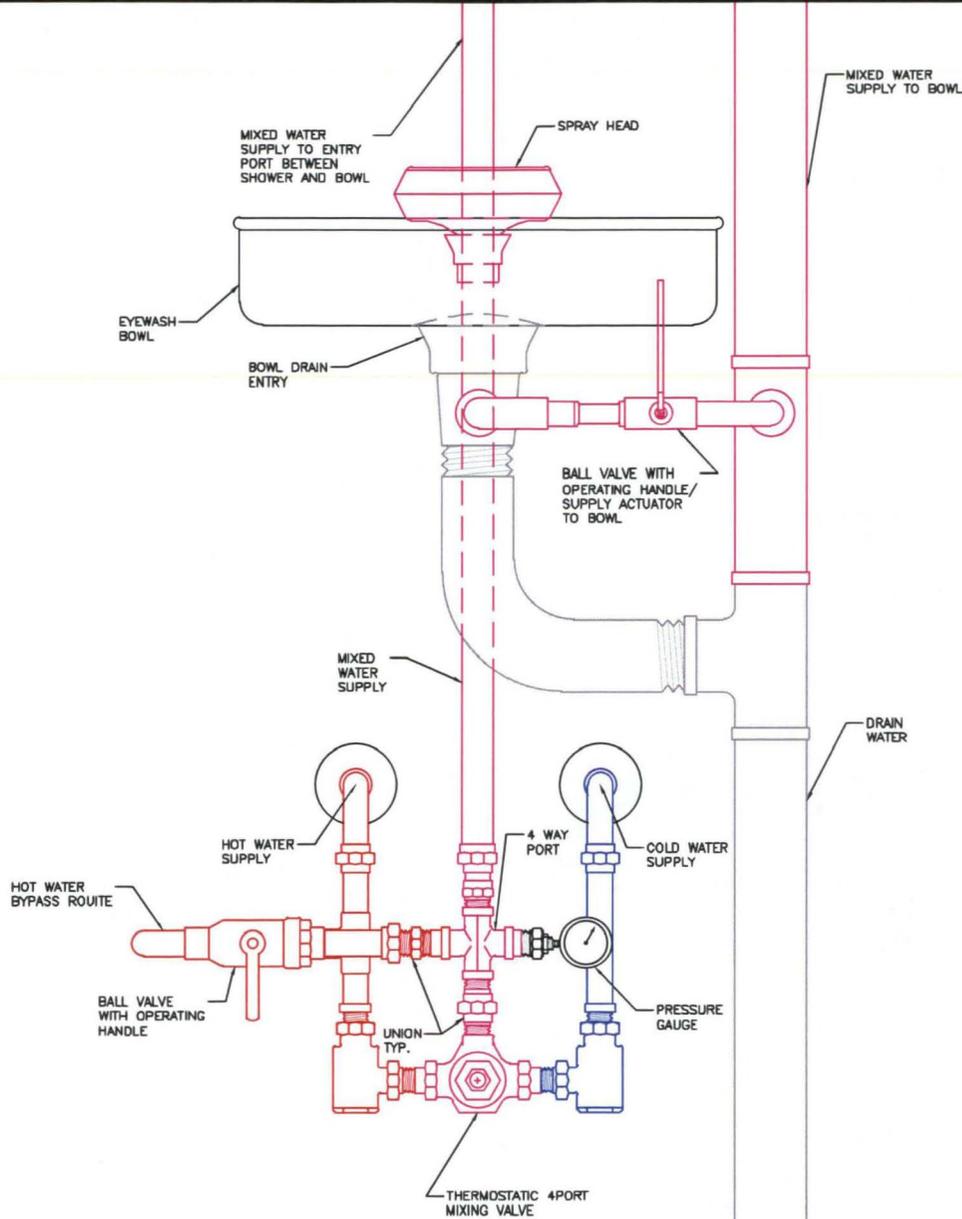

NOTES:

1. REFER TO PLUMBING SYSTEMS MANUAL AND SCHEDULE TO COORDINATE SYSTEMS INSTALLATION WITH EACH LOCATION THAT REQUIRES A SPECIALIZED APPLICATION.
2. CONTRACTOR MUST VERIFY ALL FIELD CONDITIONS PRIOR TO WORK START AND AFTER WORK COMPLETION.

Revisions	Date

--

**Office of
Facilities
Management**

Approved: Director, VA Pittsburgh Healthcare System
Approved: Chief Operating Officer
Approved: Vice President, Facilities Management
Approved: Manager, Projects Section

Drawing Title EYEWASH WITH SHOWER CONTROL BYPASS DETAIL
Approved: VSN 4, Safety and Fire Protection Engineer
Approved: Site Manager

Project Title PLUMBING UPGRADES PROJECT		
Building No. #1	Scale NTS	Drawn DM
Location VA PITTSBURGH HEALTHCARE SYSTEM 320 N. HIGHWAY 280E, OMBK4 PITTSBURGH, PA 15106		

Date APR. 1, 2013
Project No.
DRAWING NO. SK 7
Dwg. 1 of 1

**Veterans
Affairs**