

# Installation

## Exterior Signs

### Footings: Post & Panel Signs

All footings must meet width and depth requirements to accommodate height and size of sign, soil conditions, wind loads and winter ground freezing.


**Style 1**  
Permanent installation in landscaped areas.

Signs installed in grass can have the raised concrete colors extended to cover the area between posts.

**Style 2**  
Permanent installation in paved areas.


#### Style 1

In landscaped areas, footing shall be boxed so as to extend 90mm (3 1/2") above grade with 50mm (2") bevel. Replace surrounding landscaping to original condition.

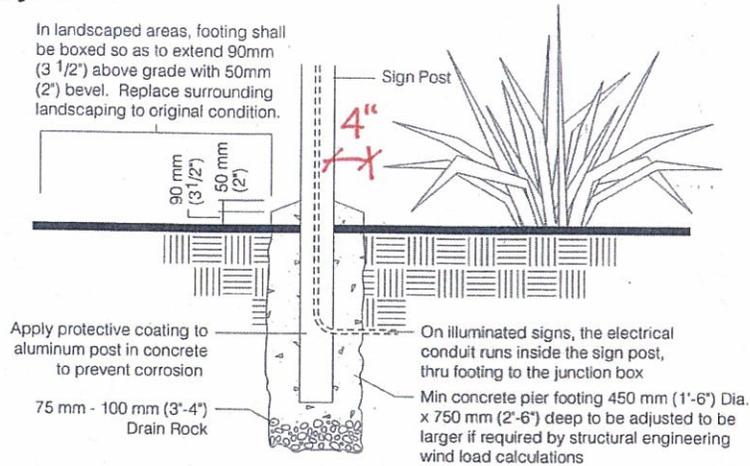

#### Style 1

In sidewalk areas, core drill or saw cut pier hole, fill flush and match material, color and finish on top surface of concrete pier.

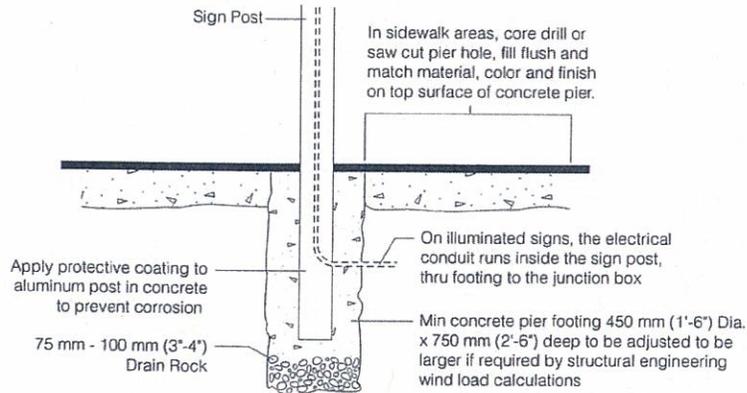

#### Style 2

