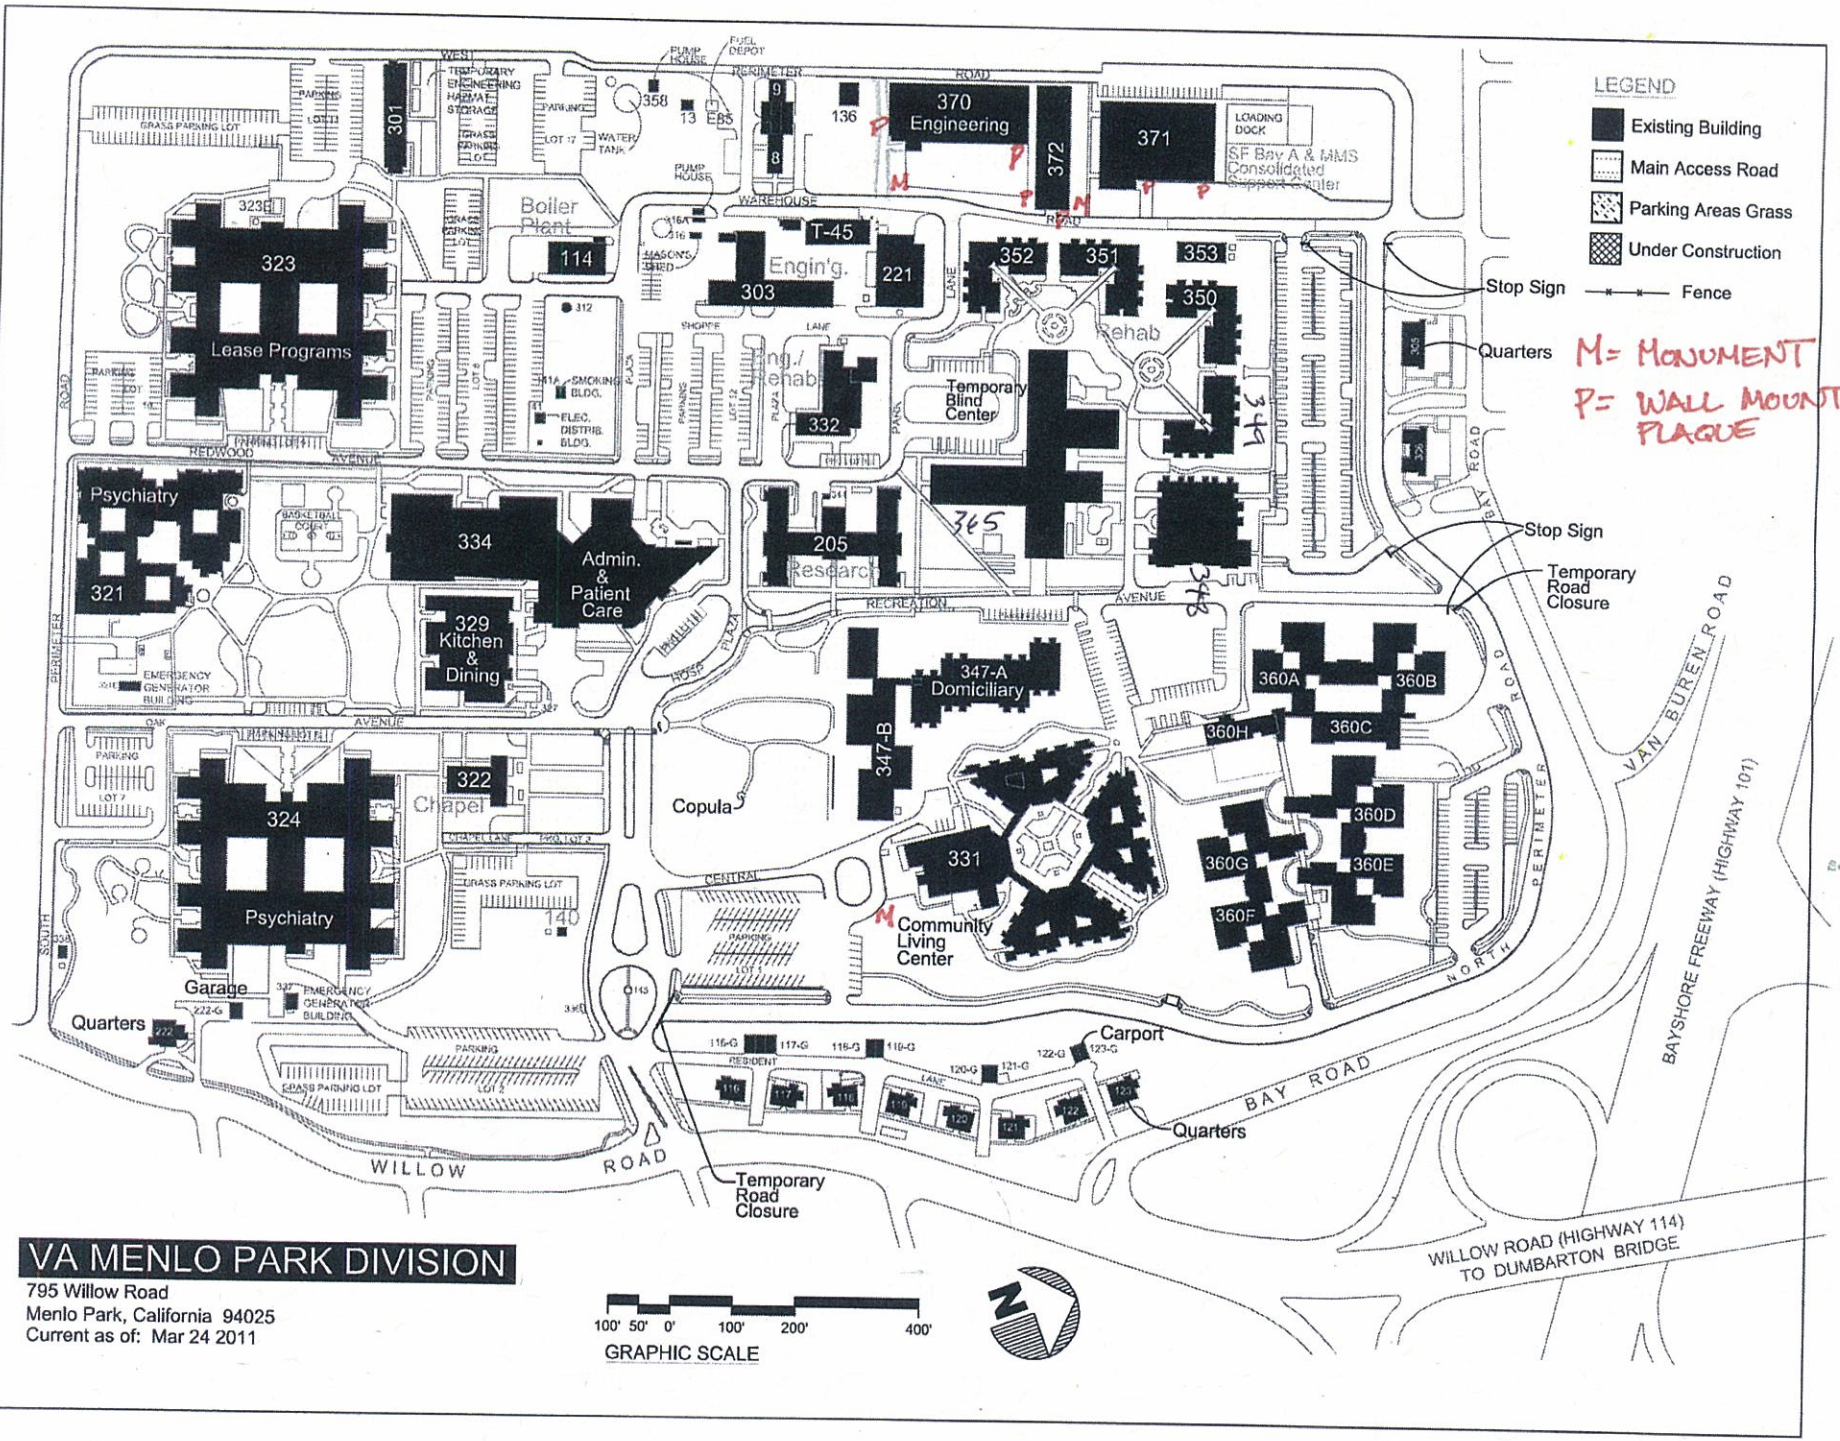

VA MENLO PARK DIVISION

795 Willow Road
Menlo Park, California 94025
Current as of: Mar 24 2011