


Identification

WALL-MOUNTED BUILDING IDENTIFICATION
Panel with return


Single-faced, non-illuminated pan
sign with applied reflective vinyl copy and accent band.

36" x 36" x 2" pan painted to match standard green w/
Ariel Bold applied reflective vinyl copy, messages as shown
2" x 36" applied vinyl yellow accent band on top area of panel


Studs for mount to masonry wall.

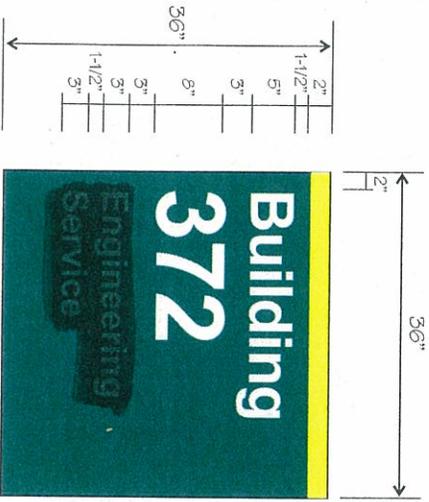

Quantity = 2
South and East
Bldg Faces

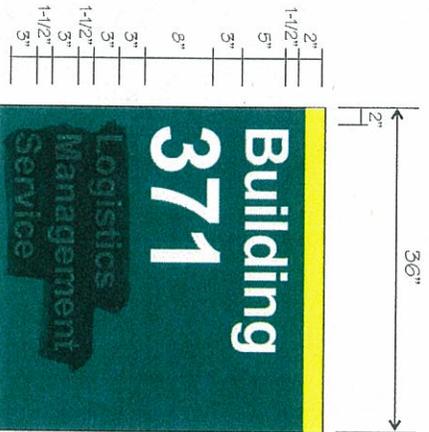

Quantity = 2
North and East
Bldg Faces

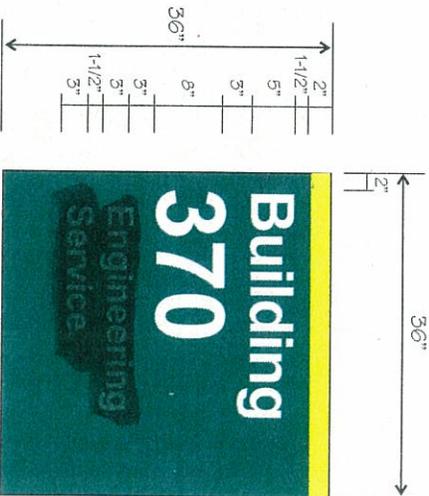

Quantity = 2
South and East
Building Faces