

AT PI 18 + 84.70 & 19 + 17.46 CONTRACTOR TO INSTALL CONCRETE PAVE
DITCH. SEE DRAWING S-103 DETAIL A

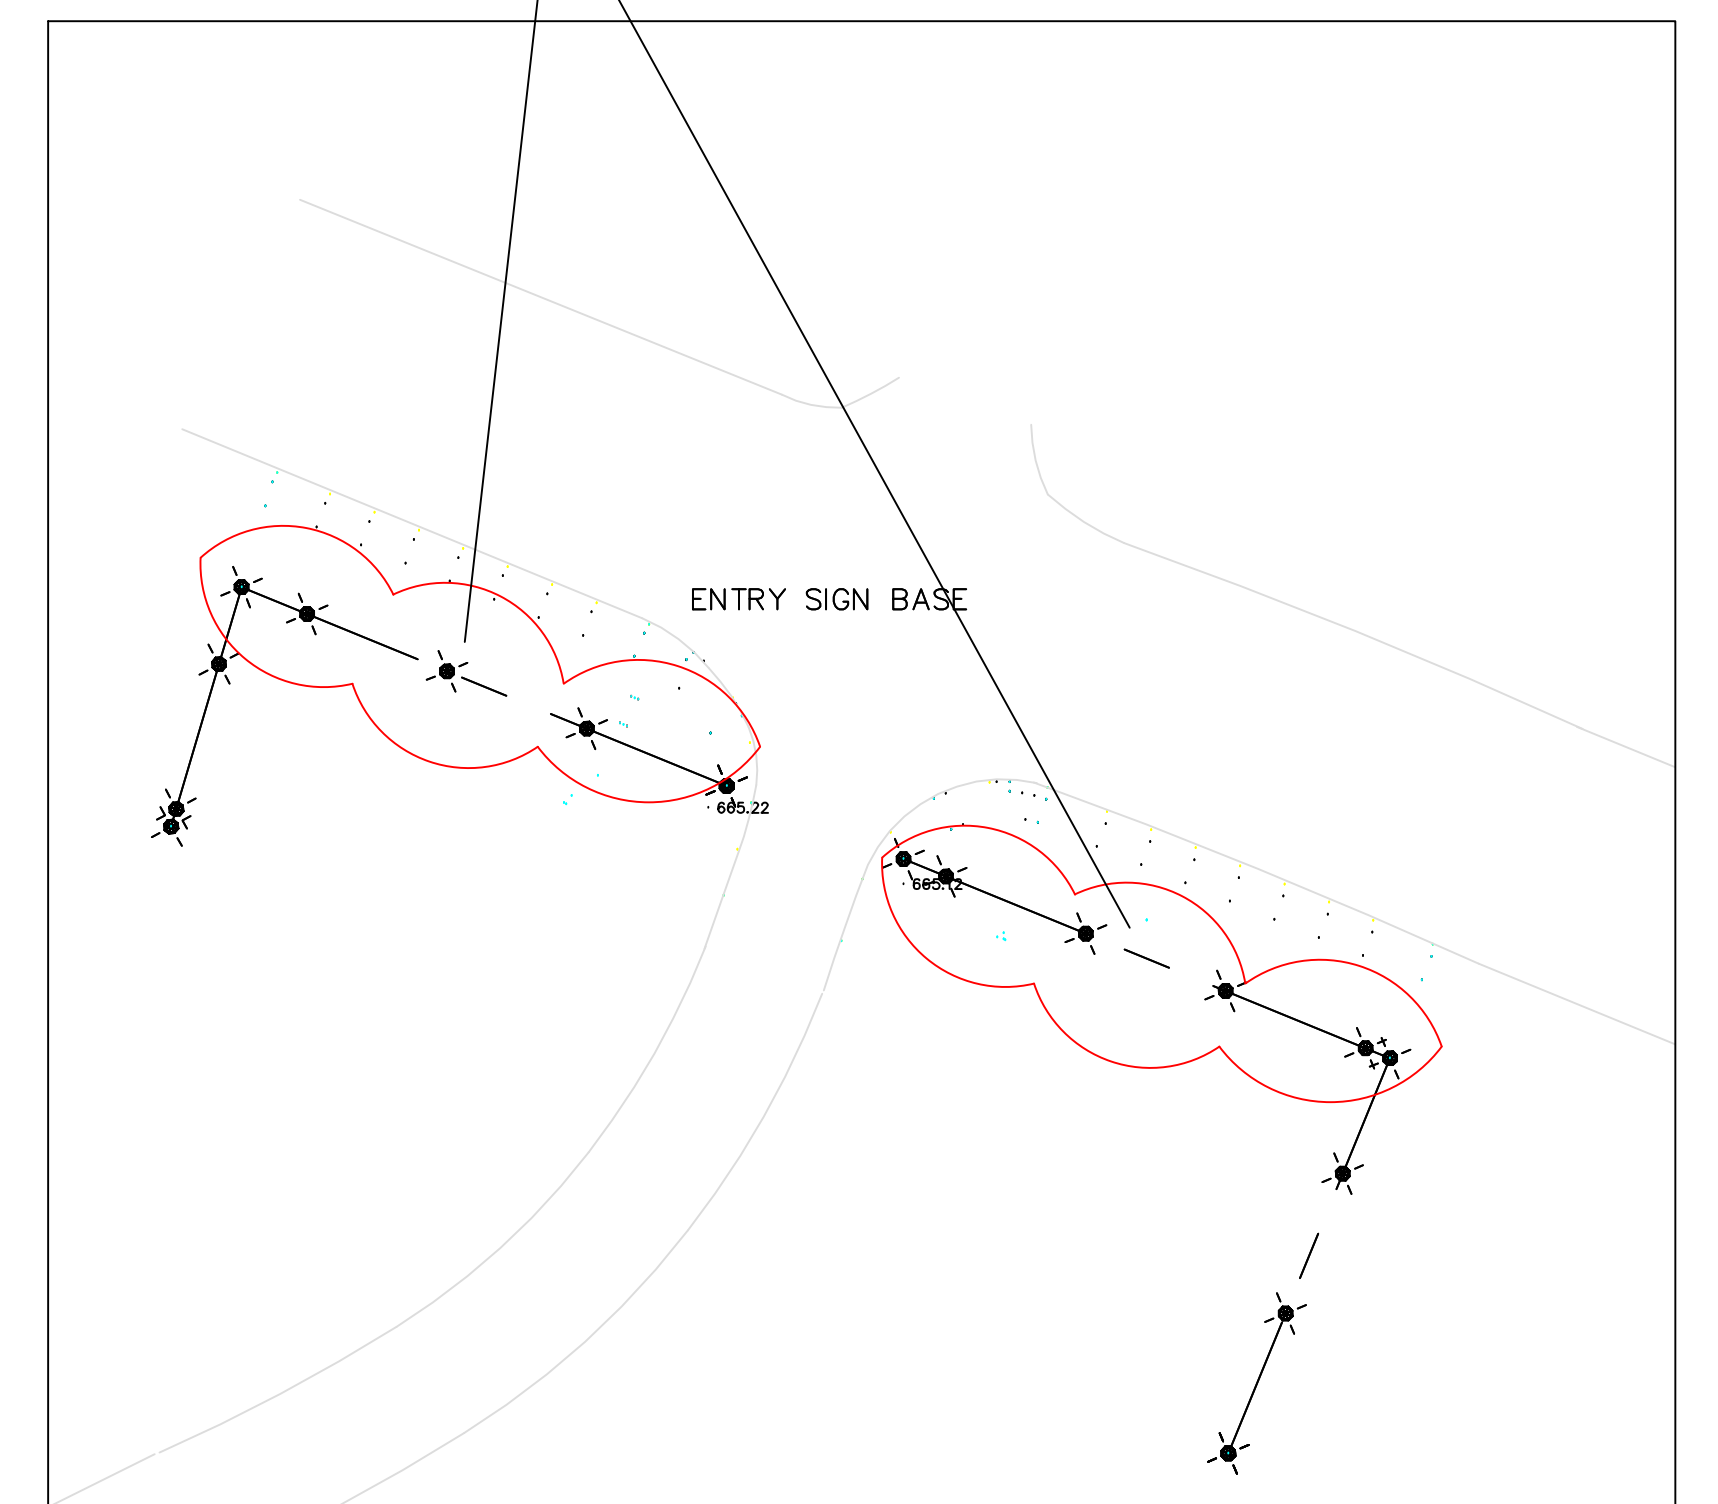
AT PI 12 + 77.77 & 13 + 10.52 CONTRACTOR TO INSTALL
PAVE DITCH. SEE DRAWING S-103 DETAIL F, G, & I.




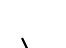

AT PI 11 + 95.69 & 12 + 77.77 CONTRACTOR TO INSTALL 6" DRAINAGE PIPE.
SEE DRAWING S-103 DETAIL F, G, & I.


AT PI 18 + 84.70 & 19 + 17.46 CONTRACTOR TO INSTALL GATE PROTECTION
FENCE. SEE DRAWING S-101

AT PI 12 + 77.77 & 13 + 10.52 CONTRACTOR TO INSTALL GATE PROTECTION
FENCE. SEE DRAWING S-101

AT PI 11 + 95.69 & 11 + 63.38 CONTRACTOR TO INSTALL GATE PROTECTION
FENCE. SEE DRAWING S-101



	COLUMN FOOTER
	FENCE LINE
	EXISTING CITY LIGHT POLE
	EXISTING DUKE POWER POLE
	EXISTING CHAIN LINK FENCE



Drawing Title NORTHWORKS METER FENCE & CONDITIONS
Approved: Safety Manager/M&O Supervisor
Approved: Chief of Facilities Management Srv.

Date	30 APR 2013
Project No.	659-14-010
DRAWING NO.	G-104
DWG. 4 OF 10	

Department of
Veterans Affairs