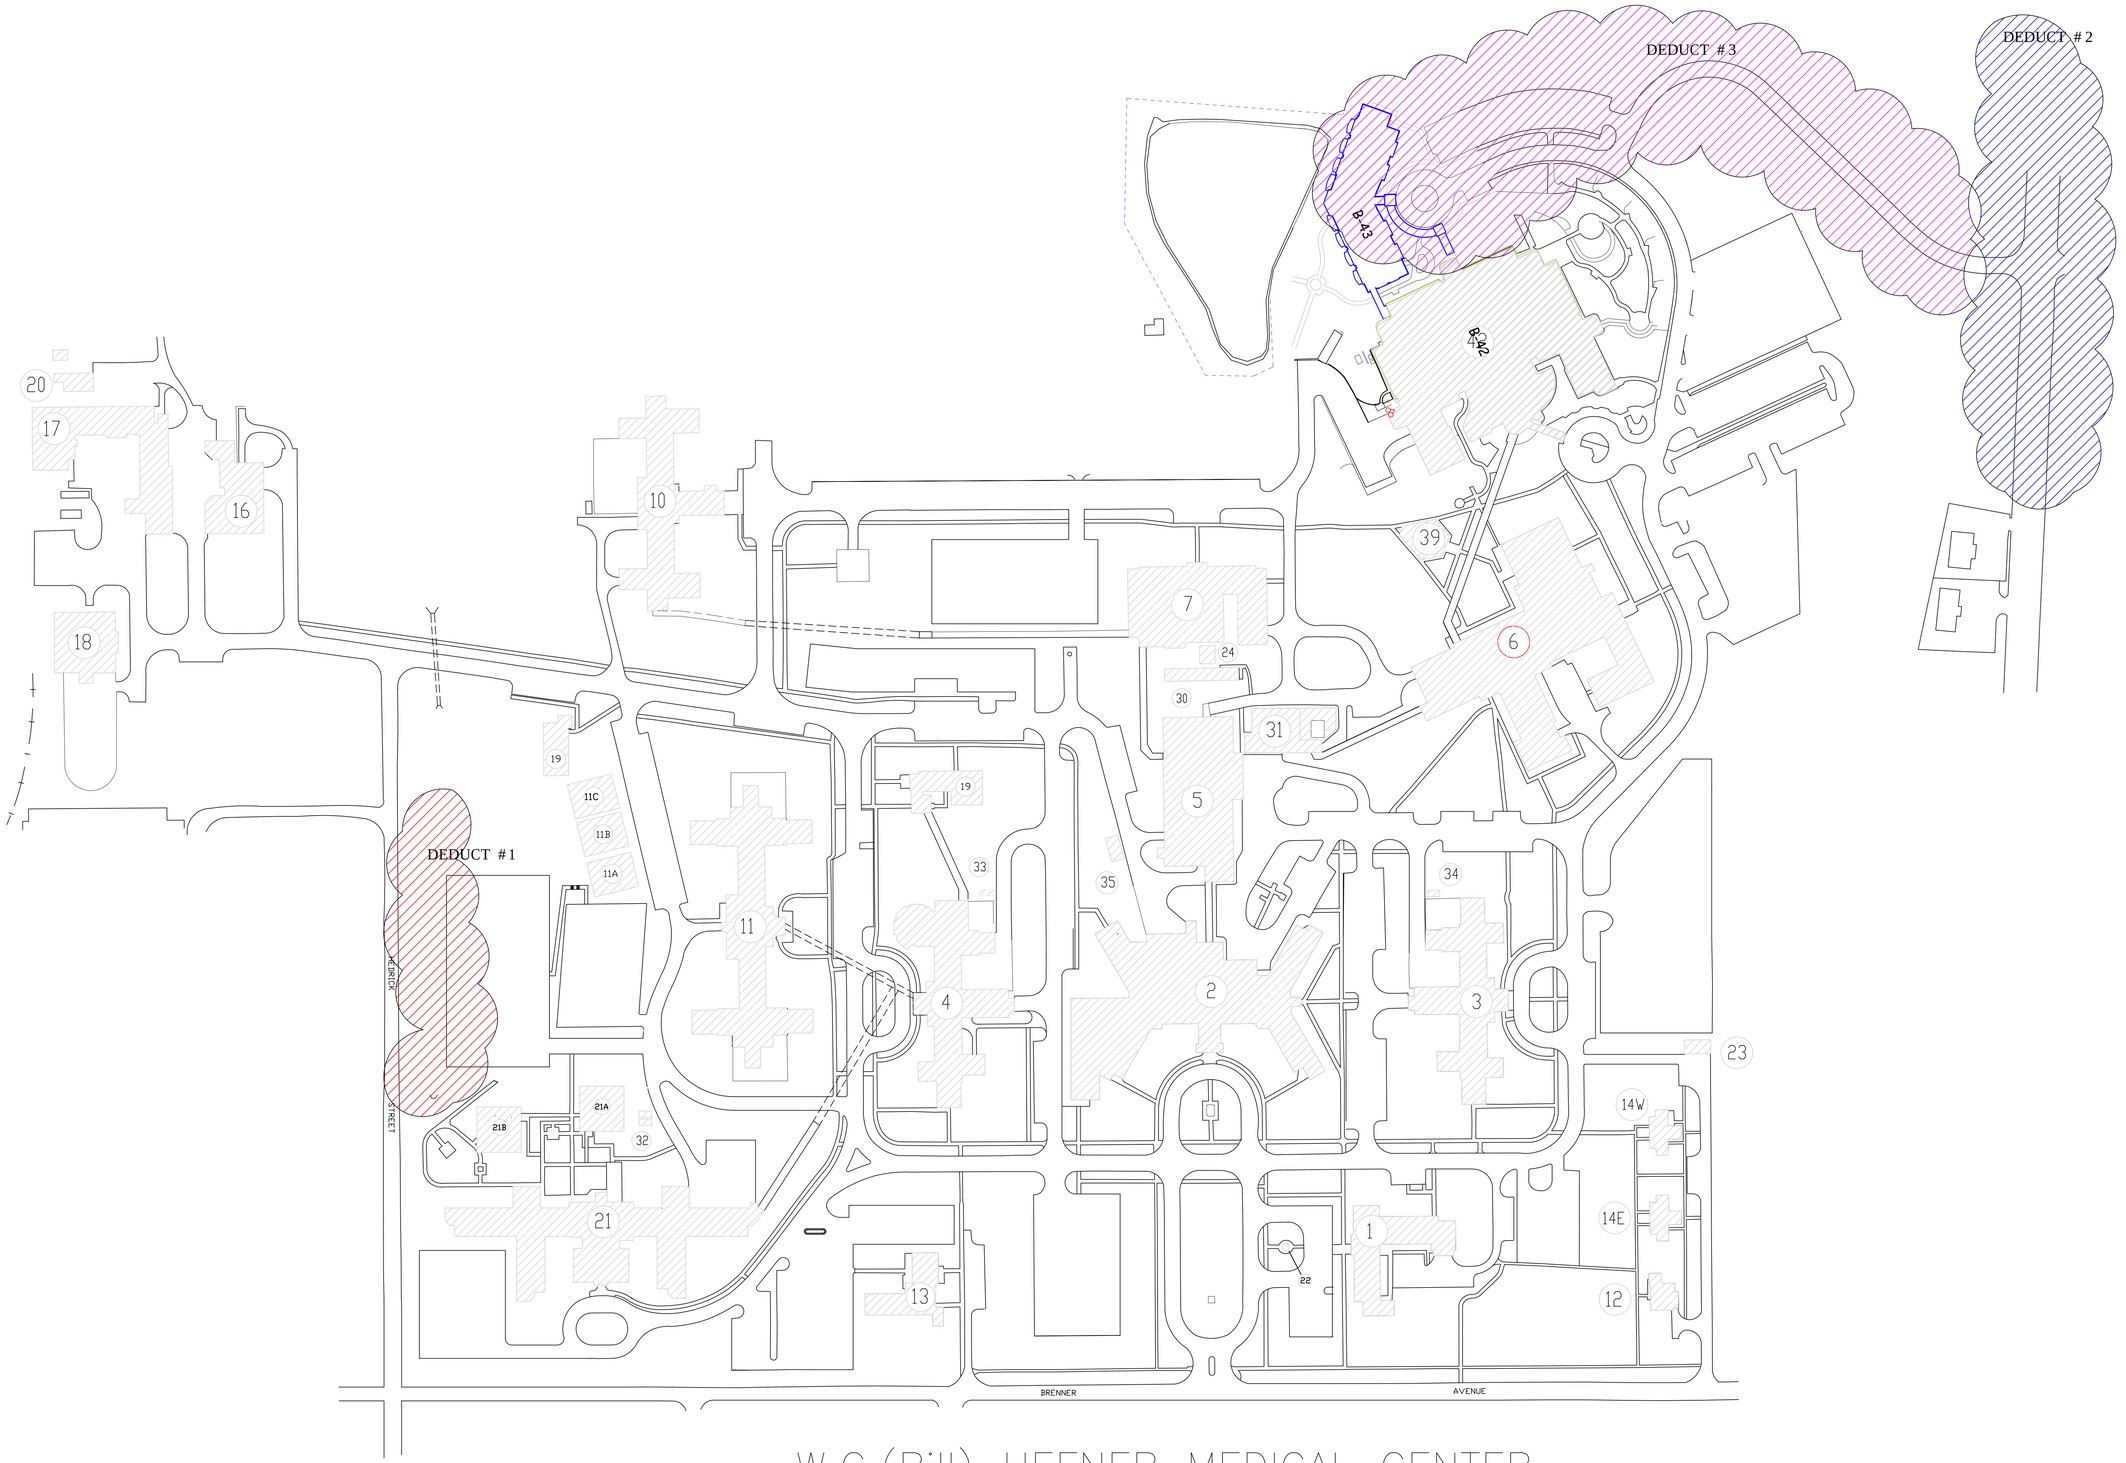


# W.G.(Bill) HEFNER MEDICAL CENTER
## SALISBURY, NORTH CAROLINA

| REVISION: CORRECT PAGE # | 21 AUG 2013 |
|---|---|
| | |
| | |
| | |
| | |
| | |
| | |
| | |
| | |
| Revision | Date |

RECOMMEND APPROVAL

| | | | |
|---|---|---|---|
| REQUESTER | Date | | |
| CHIEF OF SERVICE | Date | CHIEF OF STAFF | Date |
| ASSOC. DIR. PATIENT CARE SVC. | Date | ASSOC. DIR. for OPERATIONS | Date |
| APPROVAL BY: MEDICAL CENTER DIRECTOR | | | Date |

Drawing Title: DEDUCTS

Approved: Safety Manager/M&O Supervisor

Approved:Chief of Facilities Management Svr.

Project Title: PERIMETER FENCE ALONG HEDRICK

Building Number: CAMPUS | Checked | Drawn: BLF

Location: W.G.(Bill) Hefner Medical Center, 1601 Brenner Ave., Salisbury NC 28144

Date: 30 APR 2013

Project No.: 659-14-010

DRAWING NO. G-102

DWG. 2 OF 10

Department of Veterans Affairs