


E-9065

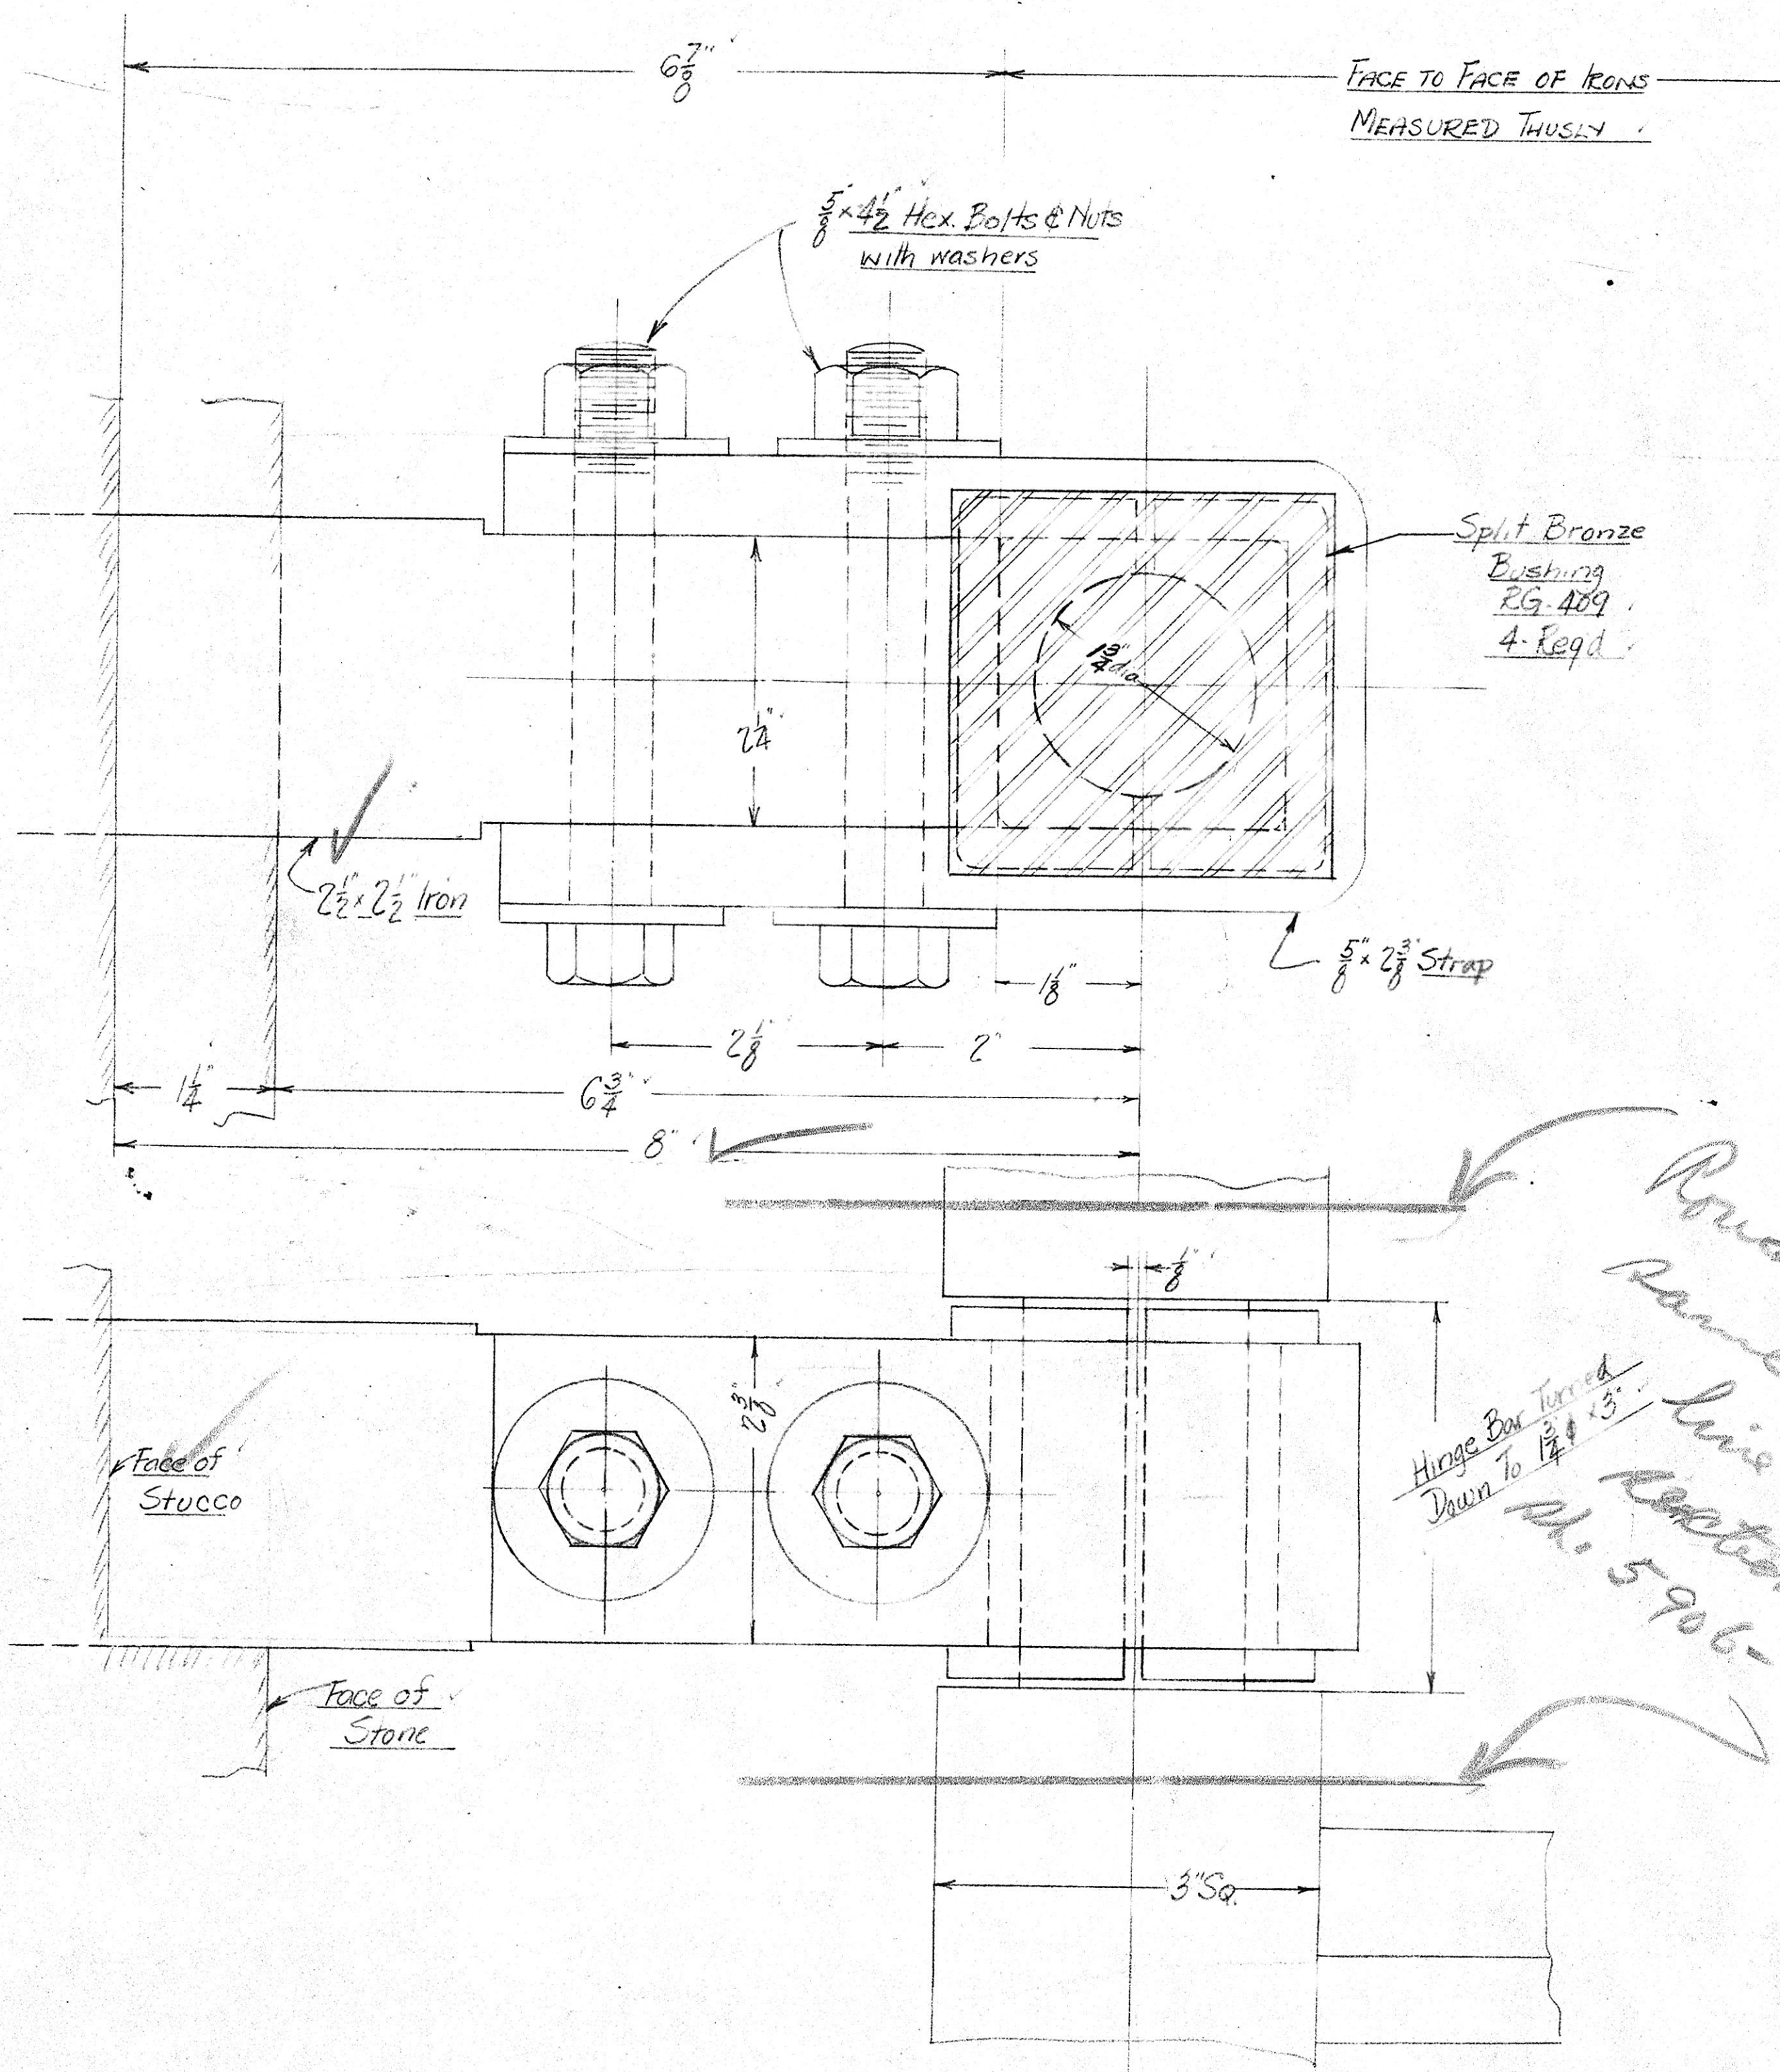

*Revised drawing
same as for
line posts, see
drawing # 5906-2
p. 5906-2*

1
UPPER HINGE DETAIL

6822-1035X4

GOLDEN GATE	
Carrico & Gautier - Gen. Contractors - San Francisco, Calif.	
Golden Gate National Cemetery - San Bruno, Calif. ORDER No. BSF-158	
Upper Hinge Detail for Double Gate	
DRAWN BY A.W. T.W.A.	APPROVED BY
CHECKED BY H	SCALE-
ANCHOR POST FENCE COMPANY ENGINEERING DEPARTMENT BALTIMORE, MD.	
5906-3	