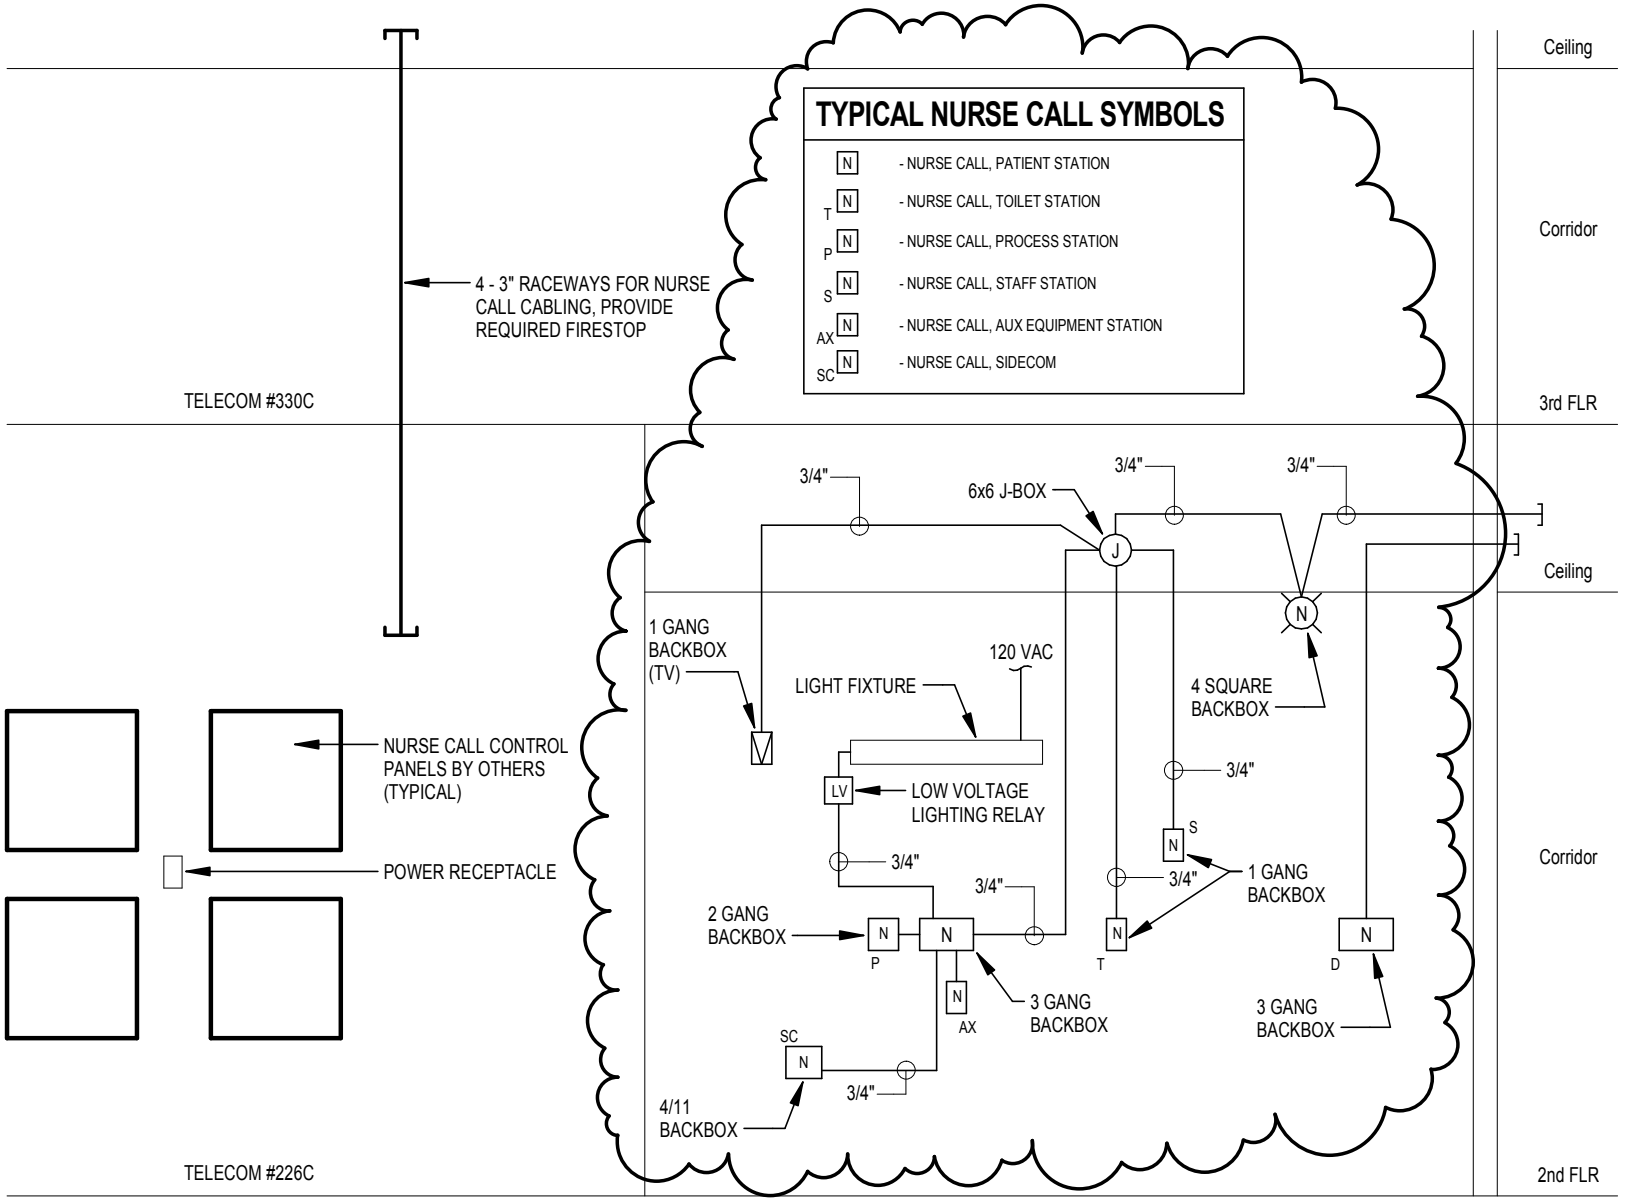

TYPICAL PATIENT ROOM LAYOUT

4D NURSE CALL ELEVATIONS -

1/4" = 1'-0"

PROJECT #	04100857
DRAWN	KAK
CHECKED	MJ
DATE	MM/DD/YY

ADD#/ASI#/CCD#/PR#	SHEET ID#
	5-EAD-E2

REF SHEET #

PROJECT TITLE

Sioux Falls VA Health Care System

Acute Inpatient Med. Unit Add & Renovation

VA Medical Center

2501 W. 22nd Street, PO Box 5046

Sioux Falls, SD 57117-5046

TSP

To Solve. To Excel. Together.