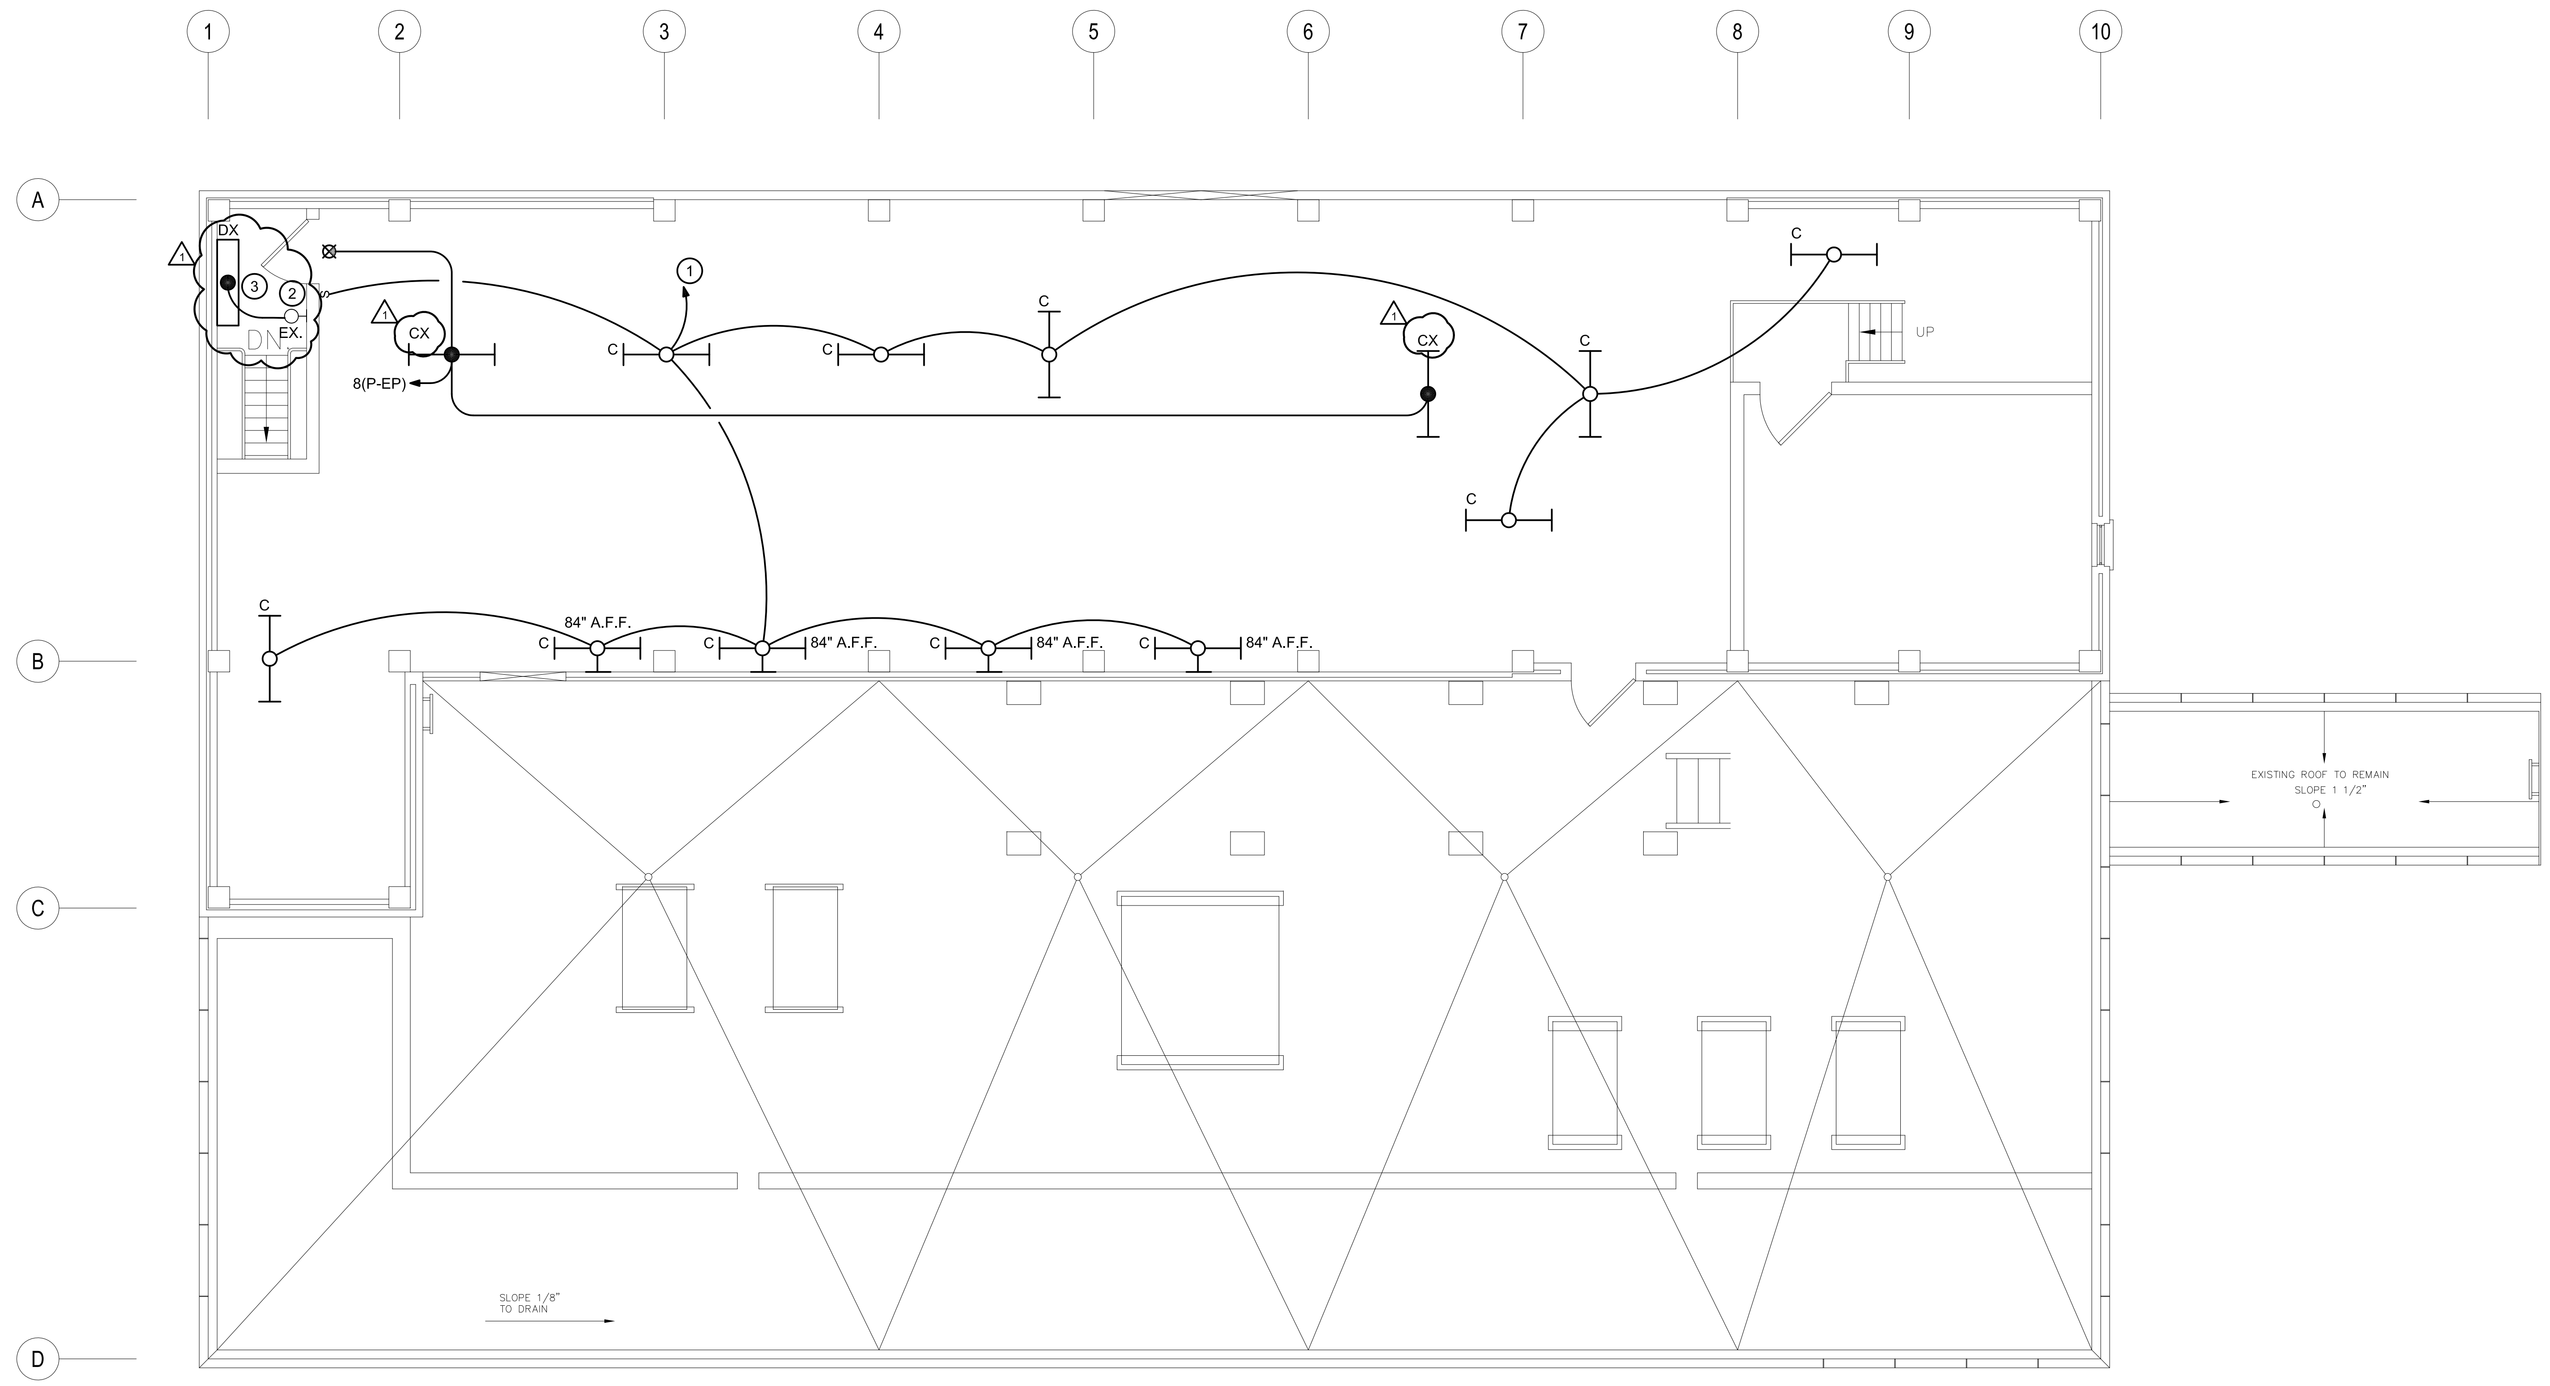

1 / 15-E8 **PENTHOUSE PLAN - LIGHTING - NEW WORK**

SCALE: 1/4" = 1'-0"

N

GENERAL NOTES:

1. REFER TO 15-E1 FOR ELECTRICAL LEGEND, ABBREVIATIONS AND GENERAL NOTES.
2. REFER TO DRAWING 15-E7 FOR ALL NEW PANEL LOCATIONS.

DRAWING NOTES:

1. INTERCEPT, EXTEND AND RECONNECT TO LIGHTING CIRCUIT WHICH WAS REMOVED DURING DEMOLITION.
2. REMOVE EX. WALL MOUNT LIGHT FIXTURE. PROVIDE SURFACE MOUNTED JBOX TO EXTEND CIRCUIT TO NEW FIXTURE LOCATION.
3. PROVIDE NEW LIGHT FIXTURE. ADJUST EXACT LOCATION BASED ON FIELD CONDITIONS. EXTEND EXISTING CIRCUIT. CONDUIT SHALL BE SURFACE MOUNTED.

Additions:	Date:
Revisions:	
ADDENDUM NO. 1 △1	08/22/13

Consultants

BURDETTE KOEHLER MURPHY & ASSOCIATES, INC.
MECHANICAL / ELECTRICAL CONSULTING ENGINEERING
1416 CLARKVIEW ROAD
BALTIMORE, MARYLAND 21209
410.323.0600 – FAX 410.377.2543

BUILDING COST CONSULTANTS
COST ESTIMATING
12917 – 30TH AVENUE
PLATTSMOUTH, NEBRASKA 68048
402.298.8260 – FAX 402.298.8290

Seal:

ARCHITECTURE PLANNING ENGINEERING
POLT DESIGN GROUP
2215 Conowingo Road, Suite 101 410.803.2141
Bel Air, Maryland 21015-1436 fax 410.836.6611
www.polt-design.com

Drawing Scale:
Drawing Start Date:
Drawing Finish Date:
Drawing Approved:

Drawing Title: ROOF PLAN – LIGHTING – NEW WORK
Approved: Associate Director for Operations:
Approved: Chief, Facilites Engineer:
Approved: Director, Medical Center:

Project Title: BUILDING 15 RENOVATION
Building No: 15
Checked: RAM
Drawn: BMG
Location: VAMHCS MEDICAL CENTER WILMINGTON, DELAWARE

Date: 07-12-2013
Project No: 460-10-116
DRAWING NO: 15-E8
Dwg. 46 Of 47

DEPARTMENT OF VETERANS AFFAIRS

BKM# 070360.060