


three inches = one foot
one and one half inches = one foot
one inch = one foot
three quarters inch = one foot
one half inch = one foot
one eighth inch = one foot
one quarter inch = one foot
one eighth inch = one foot

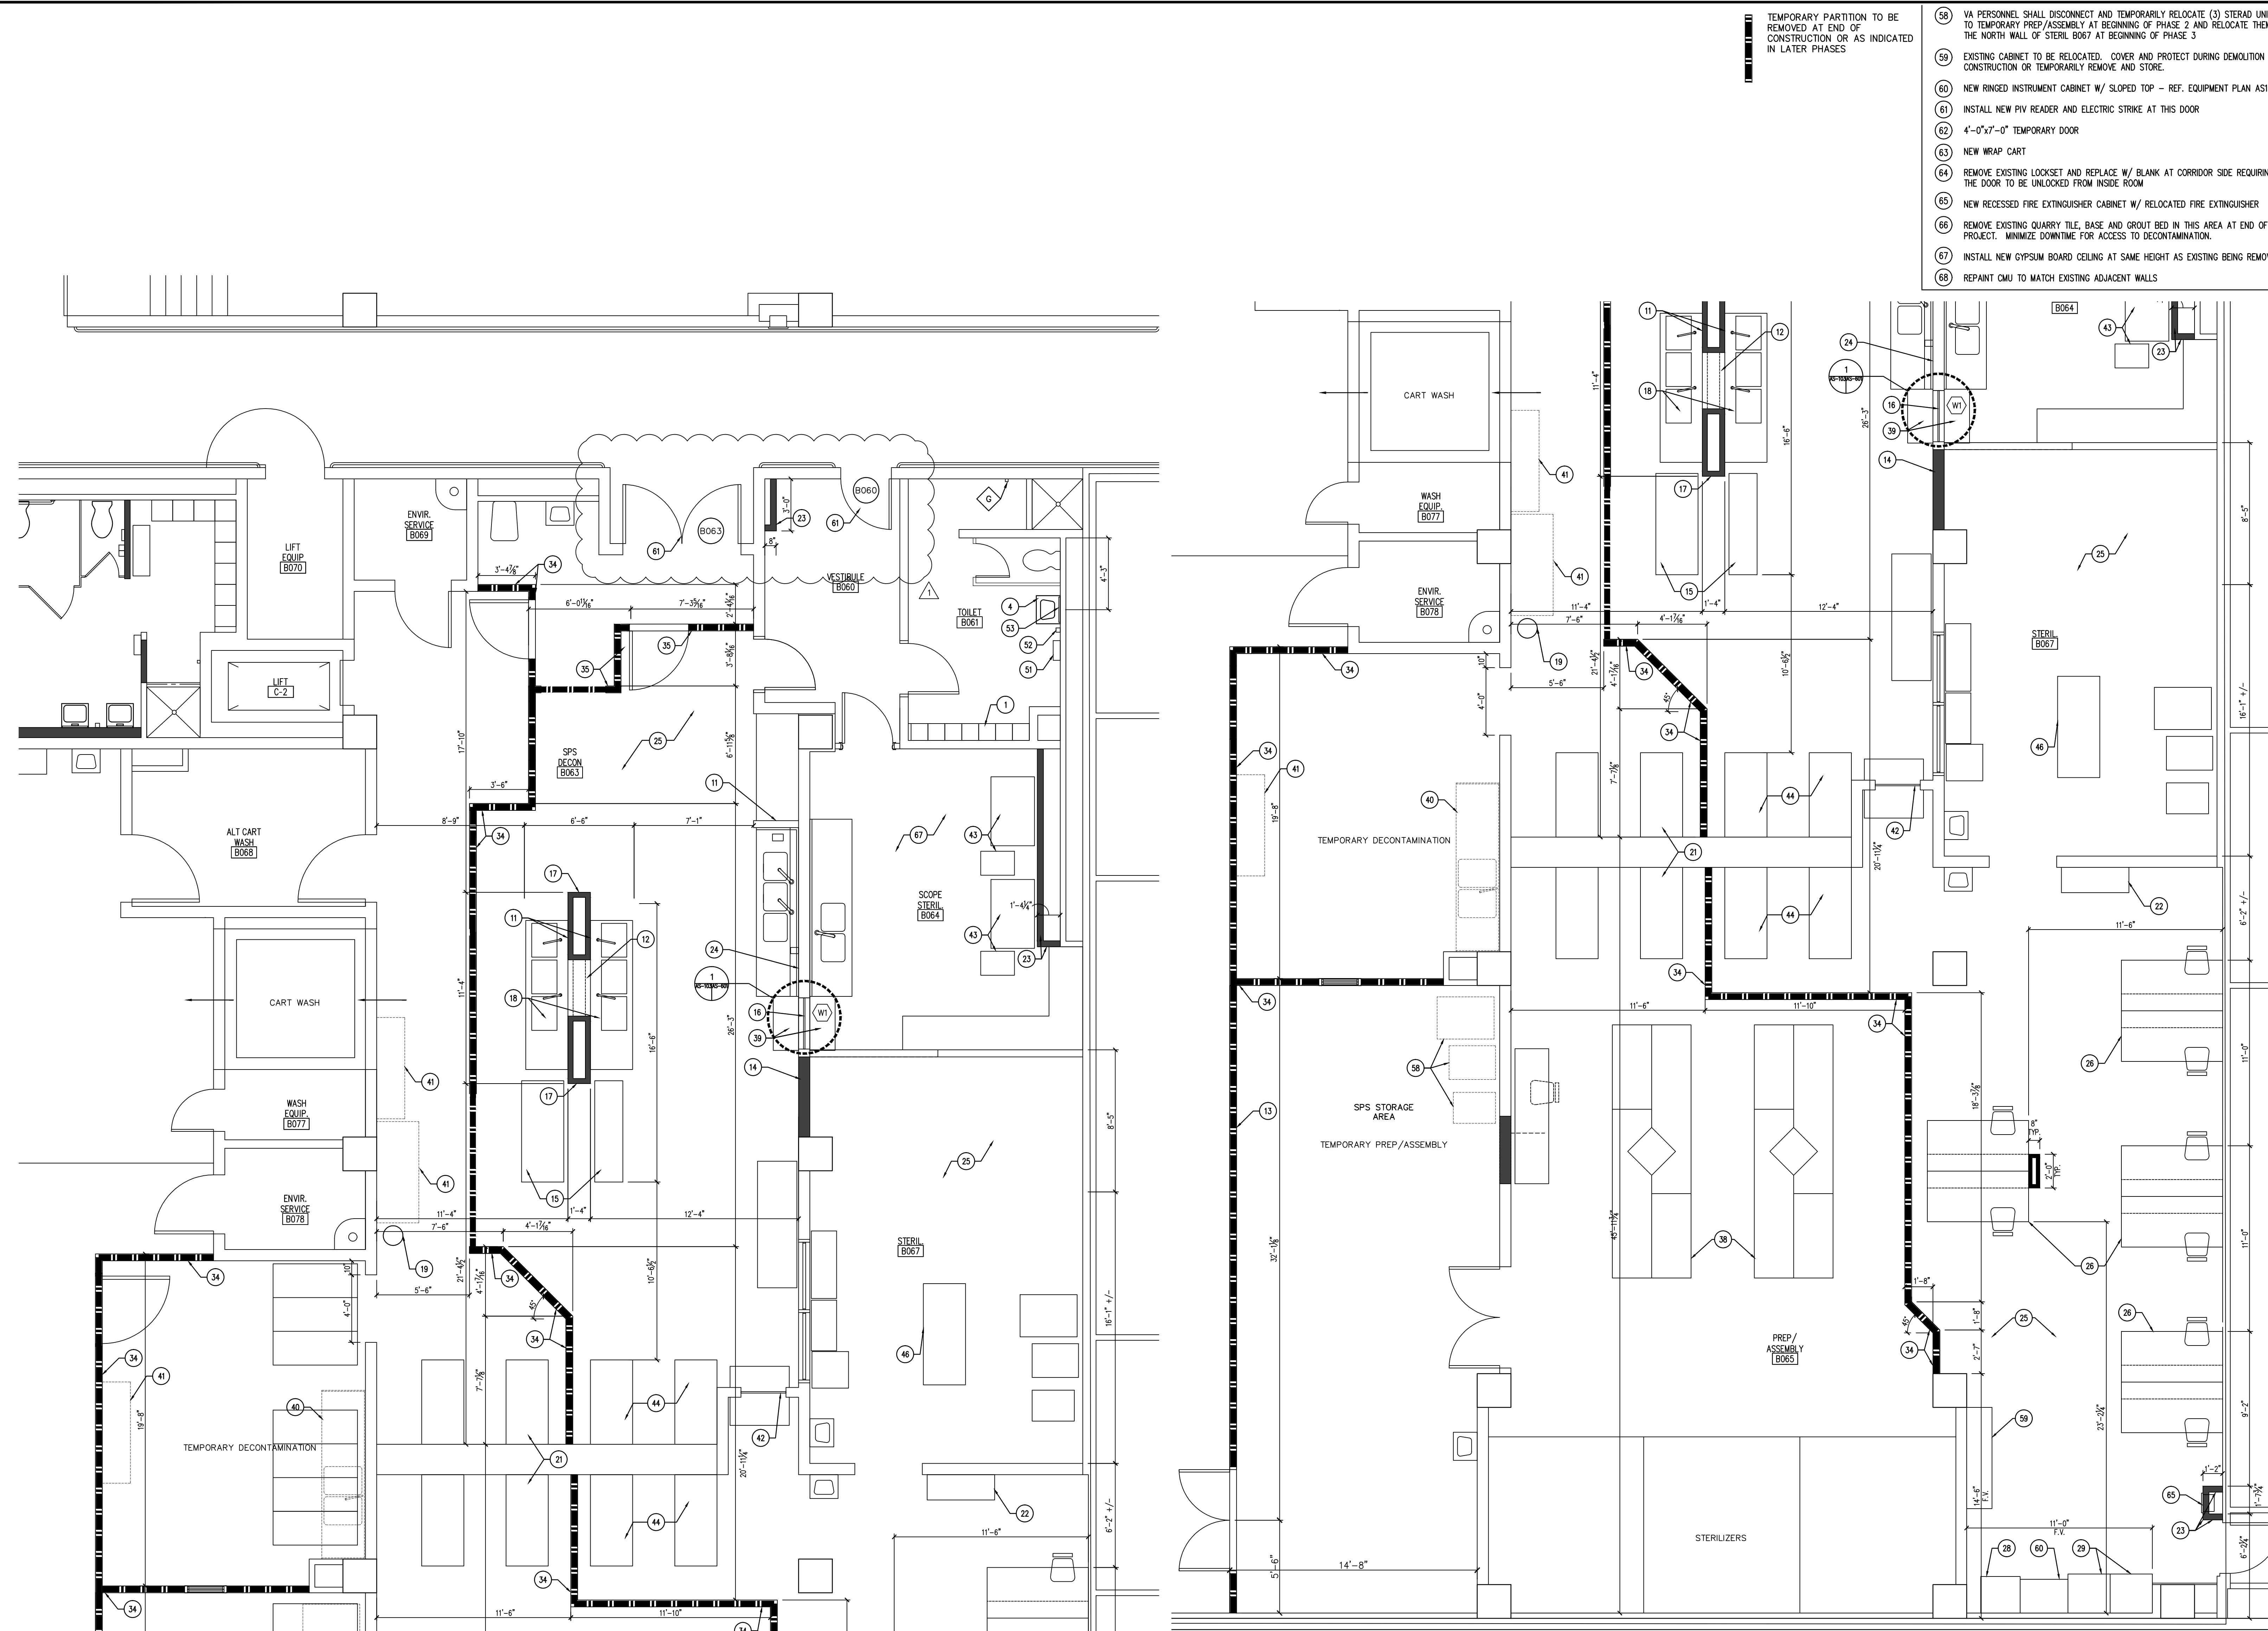

DECONTAMINATION & STERILIZATION PLAN - PHASE 2
SCALE: 1/4" = 1'-0"

PREP & ASSEMBLY PLAN - PHASE 2
SCALE: 1/4" = 1'-0"

- TEMPORARY PARTITION TO BE REMOVED AT END OF CONSTRUCTION OR AS INDICATED IN LATER PHASES
- 58 VA PERSONNEL SHALL DISCONNECT AND TEMPORARILY RELOCATE (3) STERAD UNITS TO TEMPORARY PREP/ASSEMBLY AT BEGINNING OF PHASE 2 AND RELOCATE THEM TO THE NORTH WALL OF STERIL B067 AT BEGINNING OF PHASE 3
 - 59 EXISTING CABINET TO BE RELOCATED. COVER AND PROTECT DURING DEMOLITION AND CONSTRUCTION OR TEMPORARILY REMOVE AND STORE.
 - 60 NEW RINGED INSTRUMENT CABINET W/ SLOPED TOP - REF. EQUIPMENT PLAN AS105
 - 61 INSTALL NEW PIV READER AND ELECTRIC STRIKE AT THIS DOOR
 - 62 4'-0"x7'-0" TEMPORARY DOOR
 - 63 NEW WRAP CART
 - 64 REMOVE EXISTING LOCKSET AND REPLACE W/ BLANK AT CORRIDOR SIDE REQUIRING THE DOOR TO BE UNLOCKED FROM INSIDE ROOM
 - 65 NEW RECESSED FIRE EXTINGUISHER CABINET W/ RELOCATED FIRE EXTINGUISHER
 - 66 REMOVE EXISTING QUARRY TILE, BASE AND GROUT BED IN THIS AREA AT END OF PROJECT. MINIMIZE DOWNTIME FOR ACCESS TO DECONTAMINATION.
 - 67 INSTALL NEW GYPSUM BOARD CEILING AT SAME HEIGHT AS EXISTING BEING REMOVED
 - 68 REPAINT CMU TO MATCH EXISTING ADJACENT WALLS

- ARCHITECTURAL PLAN NOTES:
- 1 NEW 2-TIER LOCKERS (7) W/ FILLER PANELS
 - 2 NEW 2-TIER LOCKERS (8) W/ FILLER PANELS
 - 3 NEW CEILING HUNG TOILET/WALL HUNG URINAL STALLS AND HARDWARE - SEE DETAIL 4/AS401
 - 4 NEW PLUMBING FIXTURES - REF. PLUMBING DRAWINGS
 - 5 NEW 3'-0"L. x 1'-0"W. SEALED MAPLE BENCH W/ SUPPORTS
 - 6 NEW ST/ST TABLE W/ CHAIRS
 - 7 NEW 2-TIER LOCKERS (15) W/ FILLER PANELS
 - 8 NEW COAT RACK
 - 9 NEW 3-5/8" METAL STUD PARTITION TO 2" ABOVE EXISTING CEILING. REWORK CEILING GRID AND BOARD FOR INSTALLATION OF NEW PARTITION.
 - 10 SPS CHECK-IN LOCATION W/ COMPUTER
 - 11 RELOCATED COMPUTERS FOR WIRELESS SCANNERS - COORDINATE FINAL LOCATIONS W/ VA COR
 - 12 NEW 4" CMU WALL TO +4'-0" AFF W/ ST/ST CAP - REF. DETAIL 1/AS401
 - 13 INSTALL SECTION OF TEMPORARY PARTITION AFTER TEMPORARY DOOR IS IN PLACE TO MAINTAIN CONTINUAL ACCESS TO PREP/ASSEMBLY B065
 - 14 REMOVE GYPSUM BOARD WALL AND INFILL W/ CMU TO MATCH EXISTING, PAINTED
 - 15 STERIS CORPORATION, AS SUBCONTRACTOR TO G.C., SHALL RELOCATE ULTRASONIC CLEANERS TO FINAL LOCATION AND CONNECT TO ROUGH-IN
 - 16 NEW PASS-THRU WINDOW - REF. ELEVATIONS ON SHEET AS401
 - 17 NEW 4" CMU WALL TO +9'-4", PAINTED - REF. DETAIL 1/AS401
 - 18 NEW ST/ST SINKS, FURNISHED BY OWNER AND INSTALLED BY CONTRACTOR - REF. PLUMBING DRAWINGS AND DETAIL 1/AS401
 - 19 RELOCATED EMERGENCY SHOWER/EYEWASH - REF. PLUMBING DRAWINGS
 - 20 6" CMU TO +4'-0" AFF W/ METAL STUD AND GYPSUM BOARD ABOVE TO RECESS WALL MOUNTED ELECTRICAL ITEMS, PAINTED
 - 21 EXISTING STEAM WASHERS/DISINFECTORS TO REMAIN
 - 22 NEW INSTRUMENT CABINET - REF. EQUIPMENT PLAN AS105
 - 23 NEW CHASE WALLS W/ 3/8" TYPE 'X' GYPSUM BOARD ONE SIDE, PAINTED OVER 3/8" METAL STUDS @ 16" O.C. MAX. TO +10'-0"
 - 24 EXISTING COMPUTER STATION TO REMAIN
 - 25 NEW RESINOUS URETHANE FLOORING SYSTEM. EXTEND SYSTEM 6" UP WALL TO PROVIDE AN INTEGRAL COVE BASE.
 - 26 NEW STERIS WORK STATIONS (8) W/ CHASE TO BE BUILT BY CONTRACTOR - REF. DETAIL 2/AS401
 - 27 NEW ST/ST TABLE - REF. EQUIPMENT PLAN AS105
 - 28 NEW LINEN CABINET - REF. EQUIPMENT PLAN AS105
 - 29 NEW INSTRUMENT DRAWERS (2) - REF. EQUIPMENT PLAN AS105
 - 30 INFILL EXISTING OPENING W/ NEW MATERIAL TO MATCH ADJACENT EXISTING MATERIALS; PAINT SUPPLY STORAGE SIDE TO MATCH EXISTING
 - 31 EXISTING BENCH TO REMAIN
 - 32 NEW 4" CMU WALL TO CEILING TO EXTENTS INDICATED, PAINTED
 - 33 NEW WALL W/ 6" METAL STUDS @ 16" O.C. MAX W/ 3/8" TYPE 'X' GYPSUM BOARD ROOM SIDE TO CEILING TO EXTENTS INDICATED
 - 34 TEMPORARY DUST PARTITION (1-HOUR RATED SMOKE WALL): METAL STUD & 3/8" TYPE 'X' GYPSUM BOARD (BOTH SIDES) PARTITION TO DECK, TAPED AND PAINTED. INSTALL FIRE-RATED PLASTIC SHEETING ABOVE CEILING AT ALL PENETRATIONS TO PROVIDE AN AIRTIGHT SEAL FOR INFECTION CONTROL AND TO MANAGE AIR PRESSURE DIFFERENTIALS. REFER TO DEMOLITION SHEETS FOR ADDITIONAL PHASING NOTES
 - 35 TEMPORARY DUST PARTITION (1-HOUR SMOKE WALL): METAL STUD & 3/8" TYPE 'X' GYPSUM BOARD (BOTH SIDES) PARTITION TO HARD CEILING, TAPED AND PAINTED
 - 36 8" CMU WALL TO 4'-8", PAINTED
 - 37 EXTEND EXISTING WALL TO +10'-0" AFF W/ 8" CMU, PAINTED - REF. DETAIL 6/AS401
 - 38 EXISTING COUNTERS W/ CONDUIT COLUMNS TO REMAIN IN PHASE 2 AND BE REMOVED IN PHASE 3 AS INDICATED
 - 39 REWORKED PASS-THRU COUNTERS - SEE DETAILS ON SHEET AS401
 - 40 INSTALL VA FURNISHED ST/ST SINKS IN TEMPORARY LOCATIONS IN TEMPORARY DECONTAMINATION. INSTALL AT INDICATED LOCATIONS AT END OF PHASE 2. REF. FLOOR PLANS AND PLUMBING PLANS FOR LOCATIONS
 - 41 STERIS CORPORATION PERSONNEL, AS SUBCONTRACTOR TO GENERAL, SHALL DISCONNECT AND RELOCATE ULTRASONIC CLEANERS. RELOCATE (1) TO TEMPORARY DECONTAMINATION. MOVE TO FINAL LOCATION AT END OF PHASE 2 - SEE FLOOR PLANS FOR FINAL LOCATION. THE SECOND ULTRASONIC CLEANER SHALL BE TEMPORARILY STORED AT EAST SIDE OF TEMPORARY PREP AREA
 - 42 STERIS CORPORATION PERSONNEL SHALL REPAIR EXISTING PASS-THRU WINDOW FOR FULL OPERABILITY; DISABLING HOLD-OPEN AND CLOSING GAPS AT EDGES OF DOORS. G.C. TO COORDINATE INSTALLATION OF A CONTACT ALARM THAT WILL ACTIVATE IF DOORS REMAIN OPEN. ALARM IS TO BE AUDIBLE AND VISUAL AND LOCATED WITHIN THE DECONTAMINATION ROOM
 - 43 VA PERSONNEL SHALL DISCONNECT AND RELOCATE MEDIATOR STERILIZERS AND CARTS TO TEMPORARY STORAGE AREA AND SHALL MOVE BACK TO SCOPE STERIL B064 AT END OF PHASE 2 AND RECONNECT
 - 44 REINSTALL WASHER LOADER UNIT AFTER INSTALLATION OF NEW FLOOR SYSTEM
 - 45 INSTALL TEMPORARY DUST PARTITION FOR FLOOR WORK IN FRONT OF AUTOMATIC CART WASH. COORDINATE FLOOR WORK TO MINIMIZE AUTOMATIC CART WASH DOWNTIME.
 - 46 VA PERSONNEL SHALL RELOCATE EXISTING 6'-0" x 2'-6" W/ ST/ST TABLE
 - 47 INFILL EXISTING OPENING WITH CMU TO MATCH EXISTING FACE SIZE AND THICKNESS, TOOTH IN AND PAINT.
 - 48 VA PERSONNEL SHALL TEMPORARILY RELOCATE EXISTING MEDIATORS TO INSTALL FURRED WALL FOR PIPE CHASE
 - 49 REPAIR WALL TO MATCH EXISTING. DEMOLITION WAS REQUIRED FOR PLUMBING WORK. INSTALL CERAMIC TILE WANSKOT FULL LENGTH OF WALL TO +/- 48" AFF TO MATCH EXISTING ADJACENT TILE HEIGHT. PREPARE EXISTING/NEW WALL ABOVE WANSKOT TO RECEIVE NEW PAINT.
 - 50 INSTALL CERAMIC TILE WANSKOT AT INFILL TO +/- 48" AFF, BOTH SIDES, TO MATCH EXISTING ADJACENT TILE COLOR AND HEIGHT; PREPARE WALL ABOVE.
 - 51 RELOCATE EXISTING PAPER TOWEL DISPENSER TO LOCATION SHOWN
 - 52 RELOCATE EXISTING SOAP DISPENSER TO LOCATION SHOWN
 - 53 RELOCATE EXISTING MIRROR TO LOCATION SHOWN
 - 54 RELOCATE EXISTING SHOWER CURTAIN, ROD, AND ACCESSORIES TO LOCATION SHOWN
 - 55 STOP NEW WANSKOT 2" INSET FROM TOILET PARTITION
 - 56 INSTALL TEMPORARY DUST PARTITION FOR FLOORING WORK IN PHASE 4
 - 57 VOID

<div>35% SD SUBMITTAL 1/11/2012</div> <div>35% SD REVISION 1 1/12/2012</div> <div>65% DD SUBMITTAL 1/20/2012</div> <div>35% CD SUBMITTAL 01/30/2013</div> <div>100% CD SUBMITTAL 02/27/2013</div> <div>BIDDING DOCUMENTS 06/10/2013</div> <div>AMENDMENT 2 06/07/2013</div> <div>Revisions: _____</div> <div>Date _____</div>	<div></div> <div>Dept. of Veterans Affairs Richard L. Roudebush VA Medical Center 1481 W. 10th Street Indianapolis, IN 46202</div>	<div>CERTIFIED BY:</div> <div>_____</div>	<div>NORTH REFERENCE</div> <div></div>	<div>ARCHITECT/ENGINEERS:</div> <div></div> <div>9245 Calumet Ave., Suite 205, Munster, IN 46321 (219) 836-2120 Fax (219) 836-1129</div> <div></div> <div>7260 Shadeland Station Indianapolis, Indiana 46226 TEL 317.547.5580 FAX 317.543.0270 www.structurepoint.com</div>	<div>Drawing Title</div> <div>ENLARGED FLOOR PLANS - PHASE 2</div> <div>PROJECT ENGINEER: John Flaworski</div> <div>SCALE</div>	<div>Approved Engineering Chief</div> <div>Approved Service Chief</div>	<div>Project Title</div> <div>RENOVATE SPS</div> <div>Location</div> <div>BASEMENT A-WING</div> <div>Date</div> <div>6/10/2013</div> <div>Checked</div> <div>FMF</div> <div>Drawn</div> <div>VFS</div>	<div>Project Number</div> <div>583-12-107</div> <div>Building Number</div> <div>1</div> <div>Drawing Number</div> <div>AS-103</div> <div>3FY12</div> <div>12 of 55</div>	<div>Engineering and Facilities Management Services</div> <div> Department of Veterans Affairs</div>
---	--	---	--	---	---	---	--	--	--