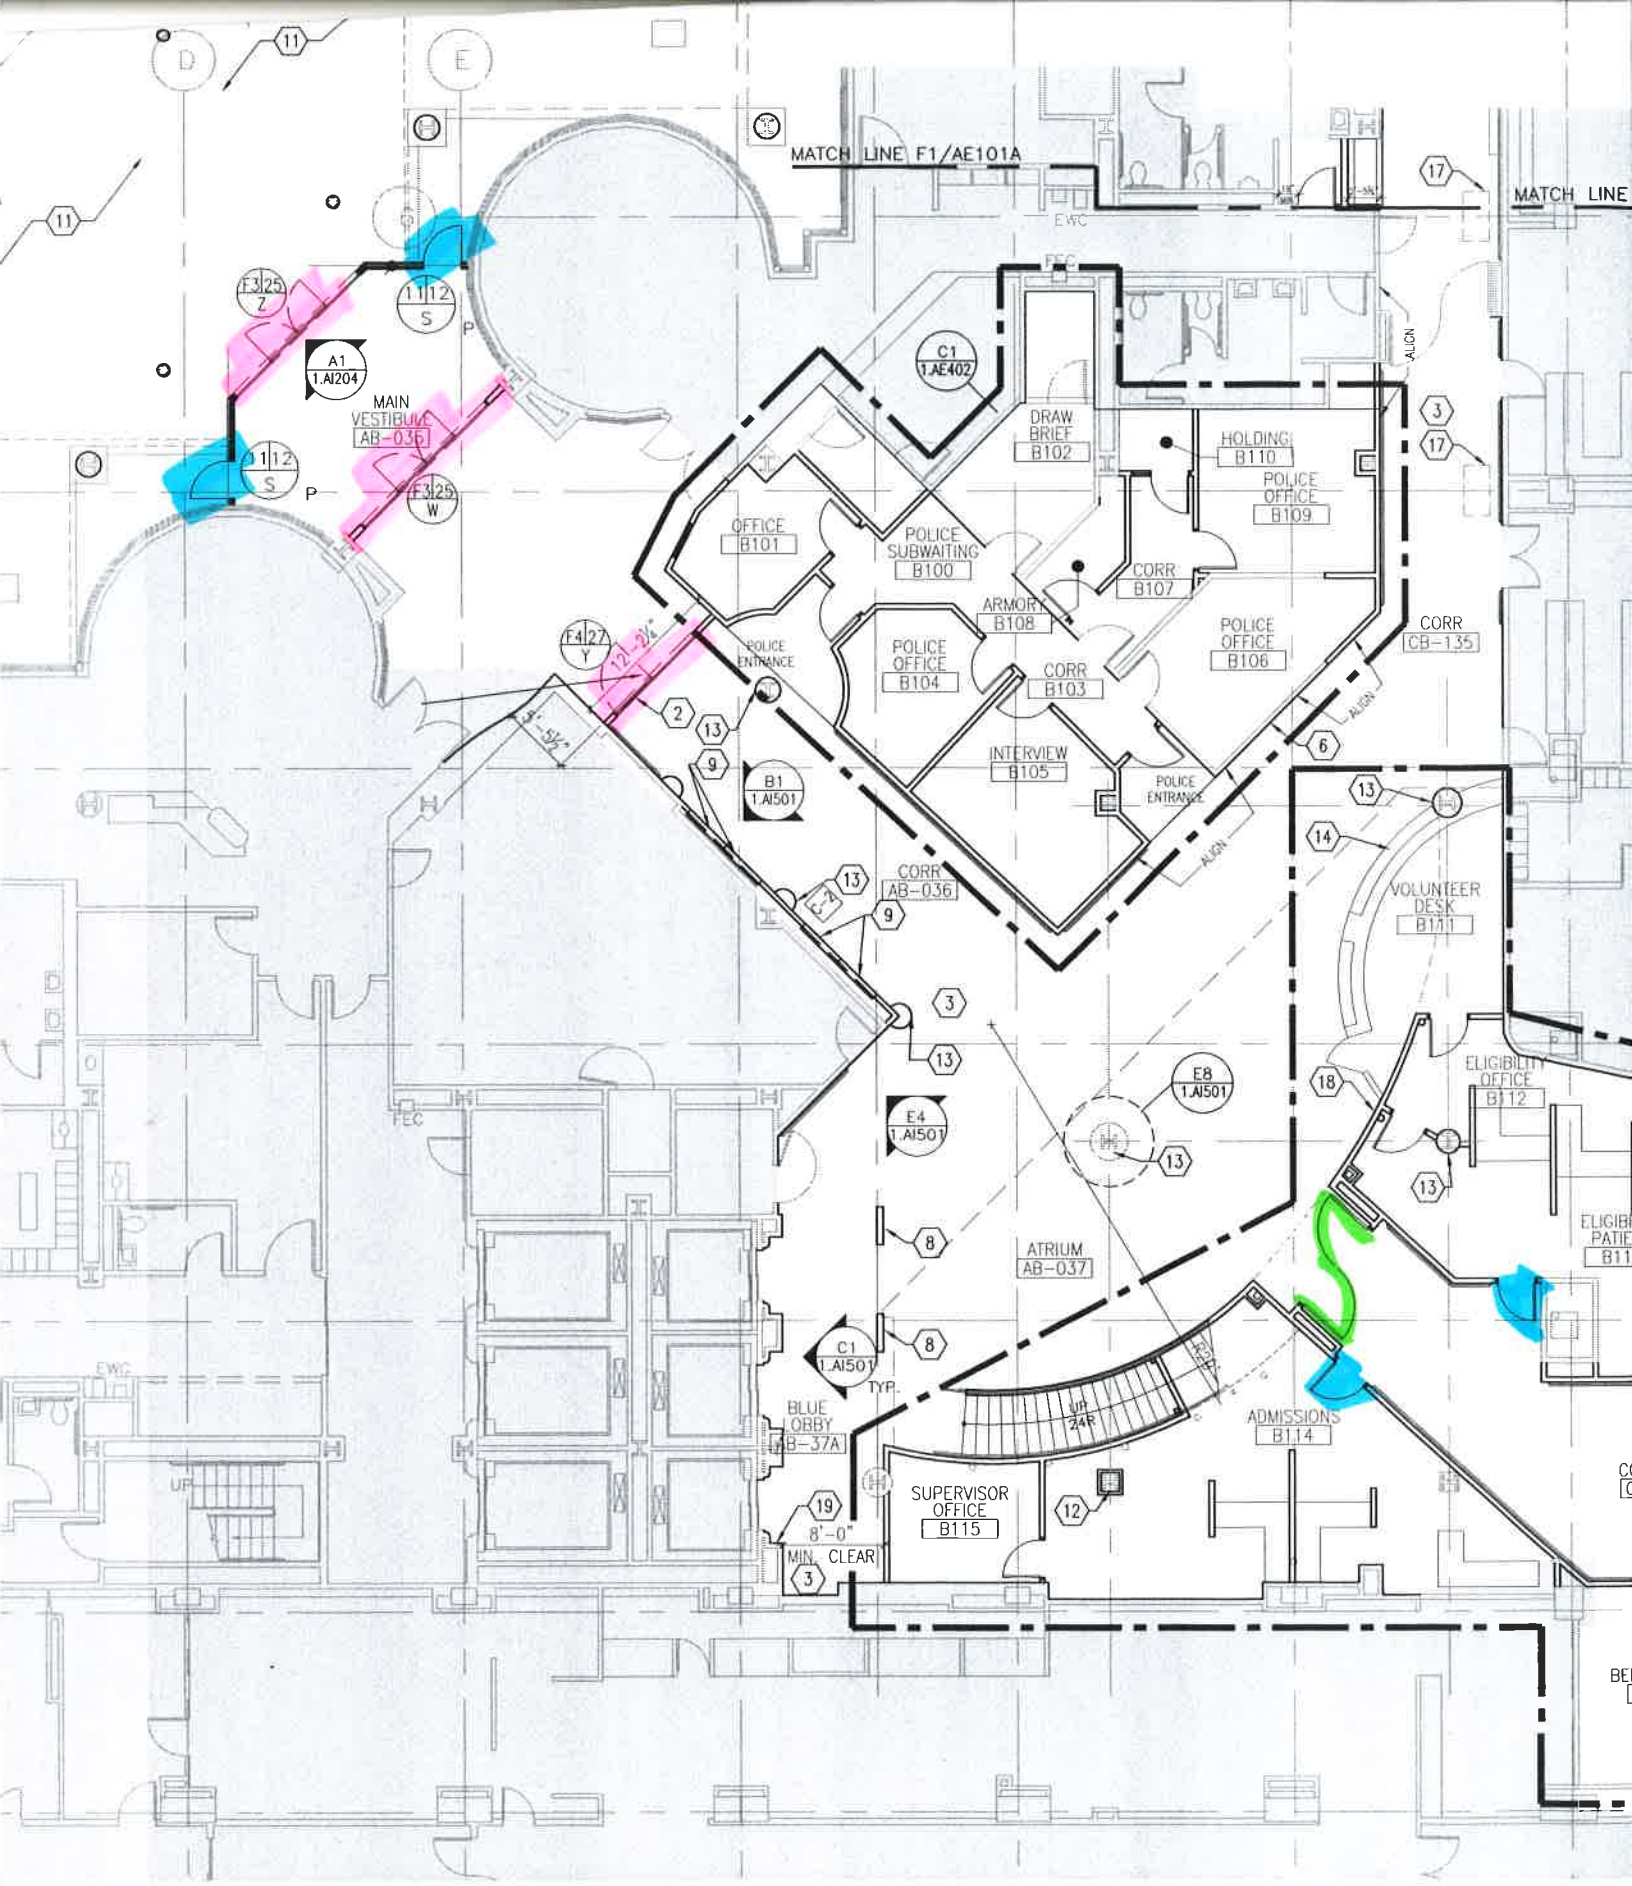

N

CONSULTANTS:

ARCHITECT/ENGINEERS: