


A
B
C
D
E
F

three inches = one foot
one and one half inches = one foot
one inch = one foot
three quarters inch = one foot
one half inch = one foot
three eighths inch = one foot
one quarter inch = one foot
one eighth inch = one foot

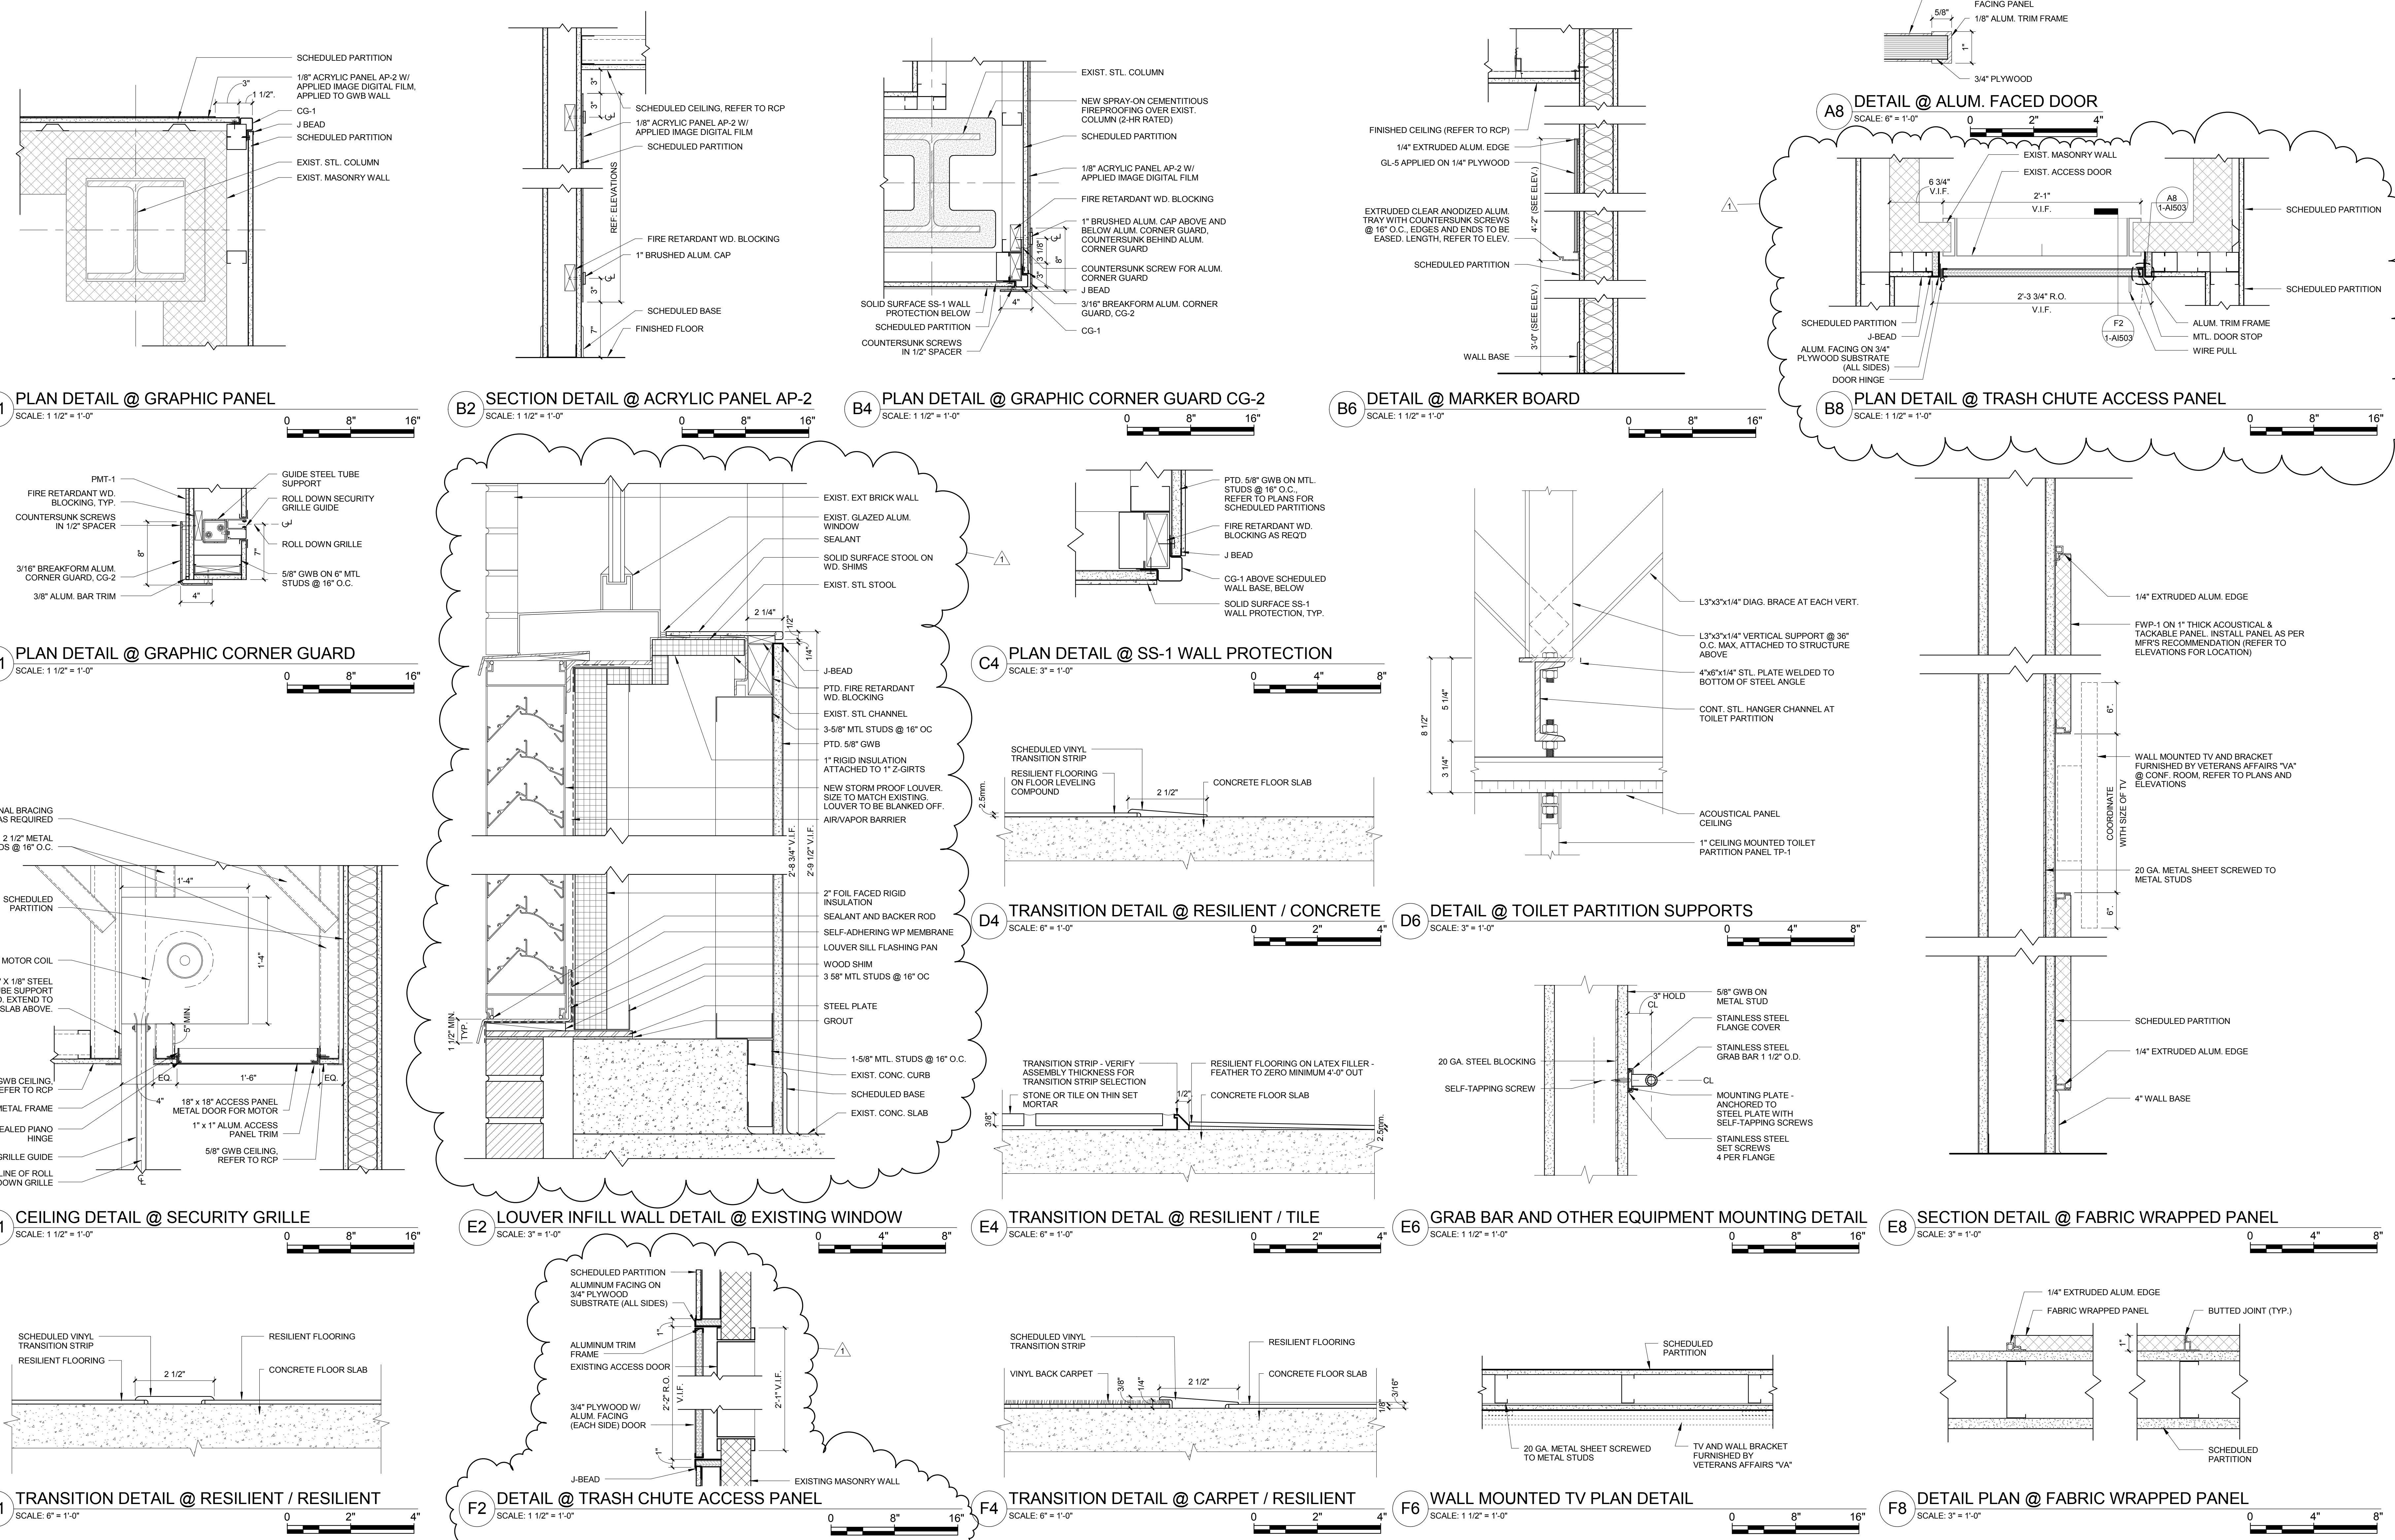

CONSULTANTS:		KEY PLAN:		ARCHITECT/ENGINEERS:		Drawing Title INTERIOR DETAILS		Project Title VA NY HARBOR HEALTHCARE SYSTEM MANHATTAN VAMC - BUILDING 1 9TH FLOOR RENOVATIONS		BUILDING IS FULLY SPRINKLERED Scale: AS NOTED	
ASBESTOS ABATEMENT CONSULTANT: Egan Environmental Consulting, Inc. 14 HIGH STREET MAHAH, NEW JERSEY 07430 Tel: (201) 848-7790 Fax: (201) 848-7791				CANNON DESIGN 360 Madison Avenue, New York, New York 10017 212.972.9800 Baltimore • Boston • Buffalo • Calgary • Chicago Houston • Los Angeles • Mumbai • New York • Phoenix St. Louis • San Francisco • Shanghai • Toronto Vancouver • Victoria • Washington DC		Approved: Project Director		Location 423 EAST 23RD STREET NEW YORK, NY 10010		Project Number 630PR2600	
ADDENDUM #1 Revisions: ISSUED FOR CONSTRUCTION								Date AUGUST 15, 2013		Building Number 1	
								Checked AH/DT		Drawing Number 1-AI503	
								Drawn MK		Office of Construction & Facilities Management VA U.S. Department of Veterans Affairs	