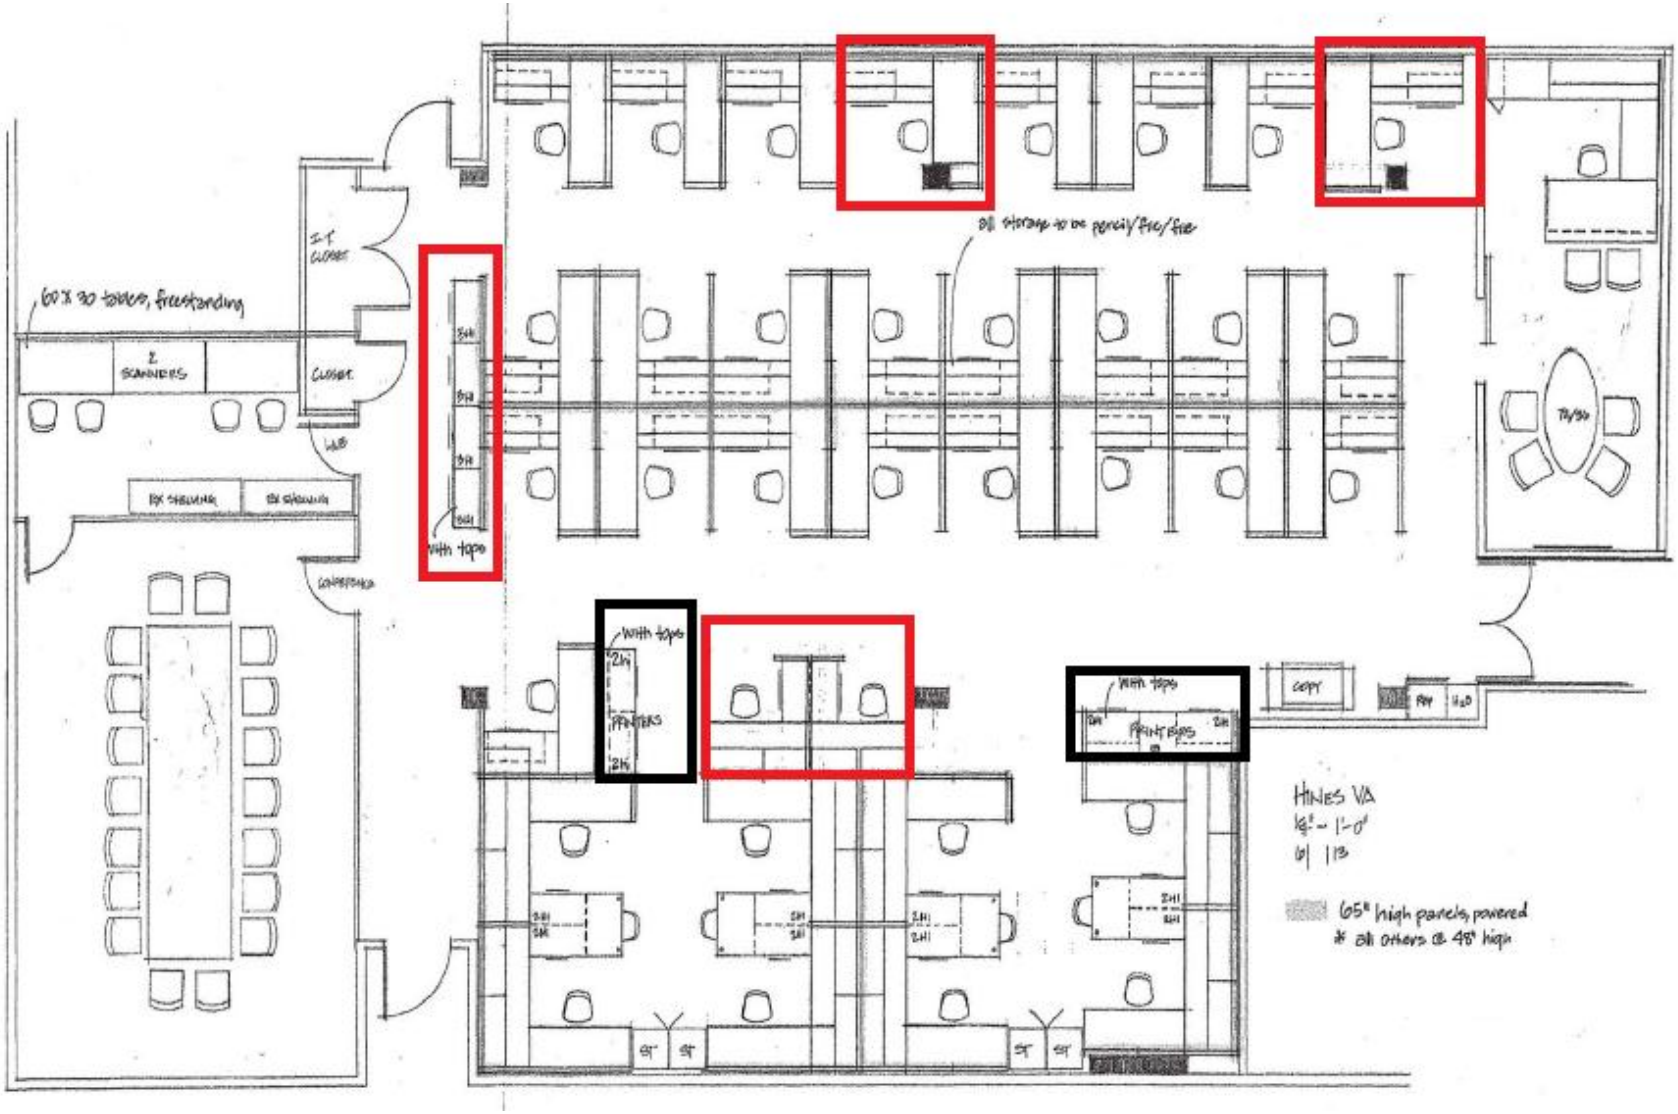

60 X 30 tables, freestanding
2 SCANNERS
CLOSET
I-T CLOSET
LAB
RX SHELVING
RX SHELVING
CONFERENCE
with tops
with tops
2H
PRINTERS
2H
with tops
PRINT BOPS
2H
COPY
RPP
H2O
all storage to be pencil/fre/fre
HINES VA
1/4" - 1'-0"
6/ 1/13
65" high panels, powered
* all others @ 48" high