
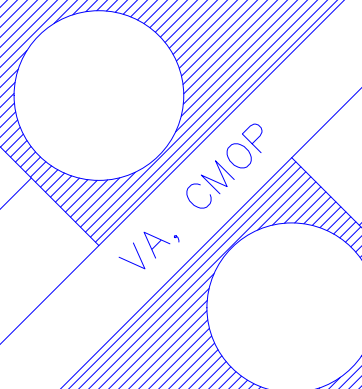


Revisions		Date	Professional Seal		<div><div></div><div>Indus Systems, Inc. 2352, Main Street, Concord MA 01742 Tel: 978-461-0555 www.indus-systems.com</div></div>		Drawing Title FIRST FLOOR PLAN ARCHITECTURAL		Project Title AS-BUILT Drawings		Date 03-04-2013		<div><div></div><div>VA Department of Veterans Affairs</div></div>	
Site: HINES		Building: CMOP		Drawn:		Checked:		Approved:		Project No.				
Location: VA CMOP				Approved:						Drawing No.				