




three inches = one foot
one and one half inches = one foot
one inch = one foot
three quarter inch = one foot
one half inch = one foot
three eighth inch = one foot
one quarter inch = one foot
one eighth inch = one foot
one sixteenth inch = one foot

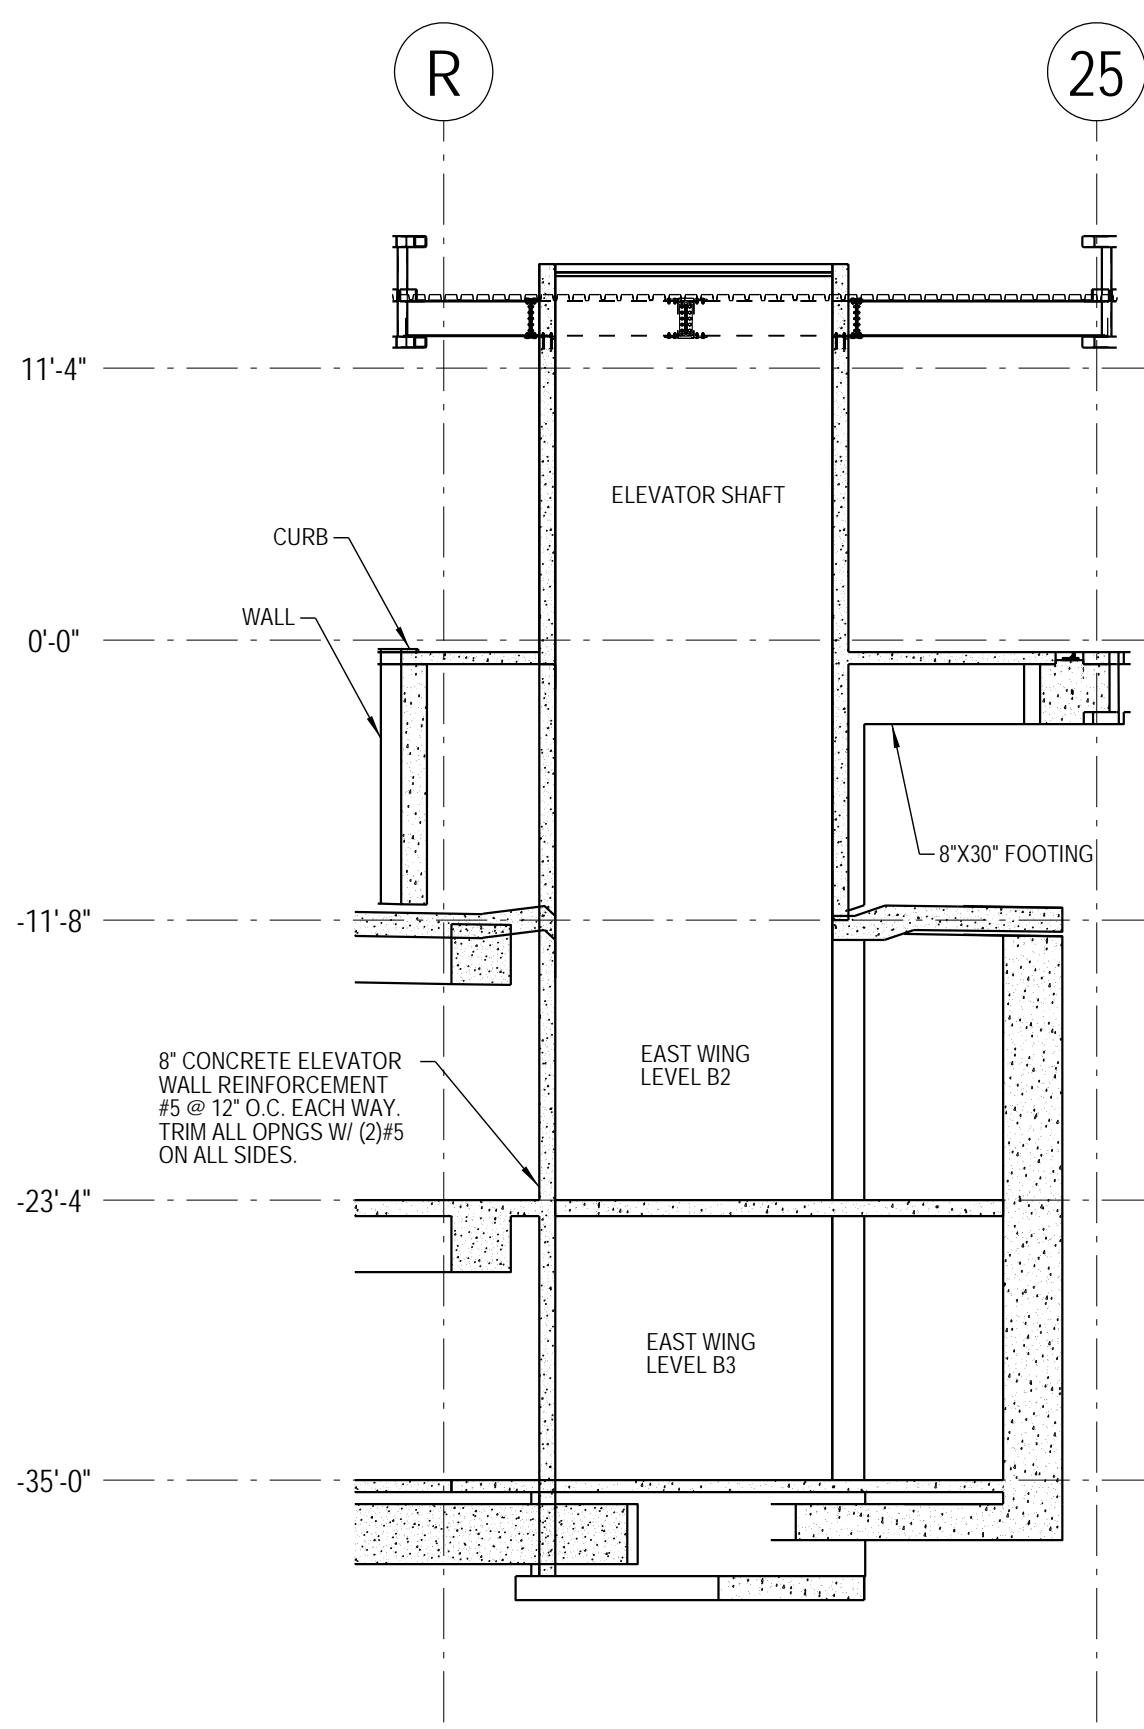


C1 ELEVATION @ ELEVATOR WEST SIDE
SCALE = 1/8"

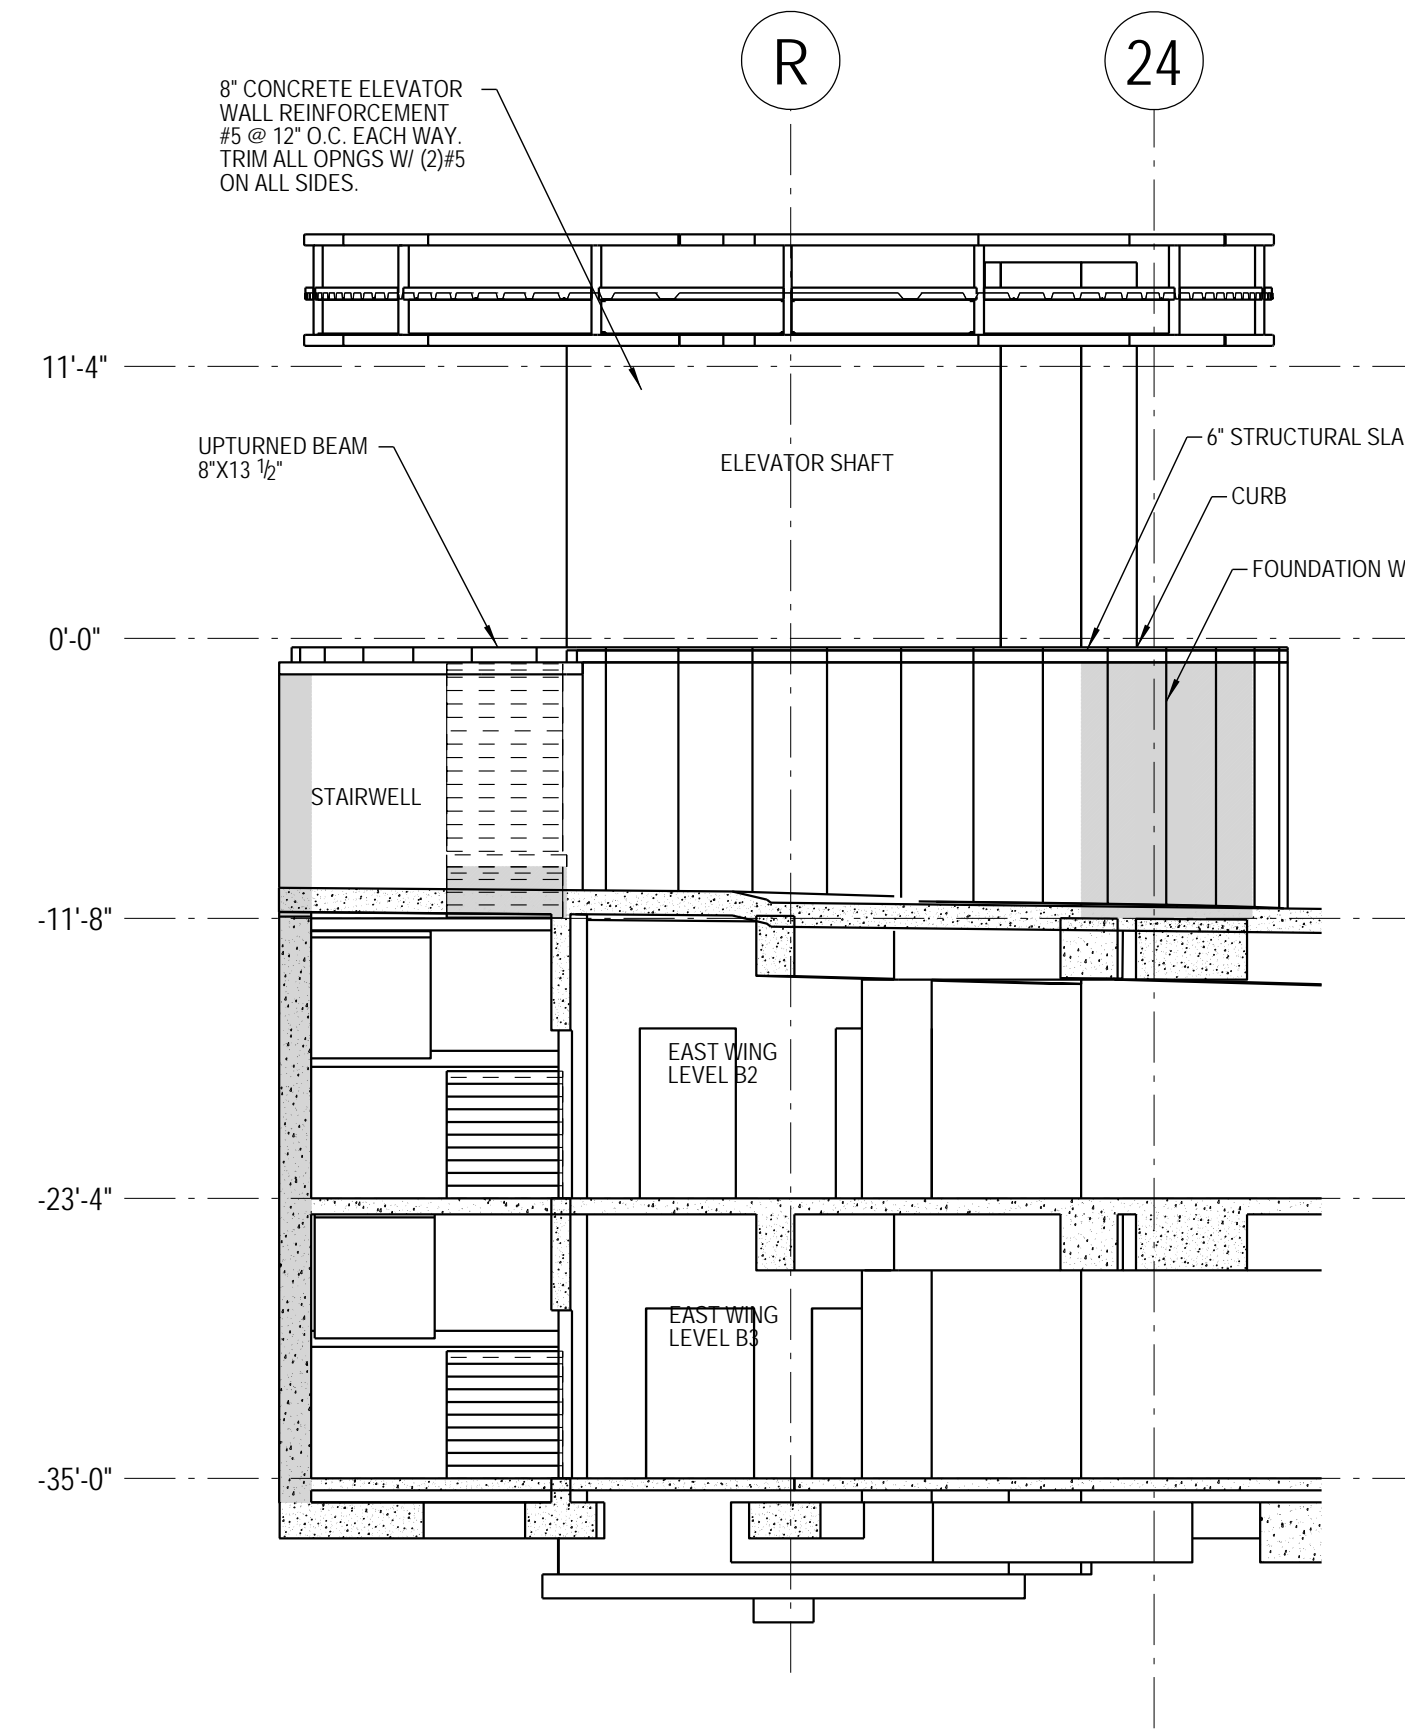


C2 ELEVATION @ STAIRWELL NORTH SIDE
SCALE = 1/8"

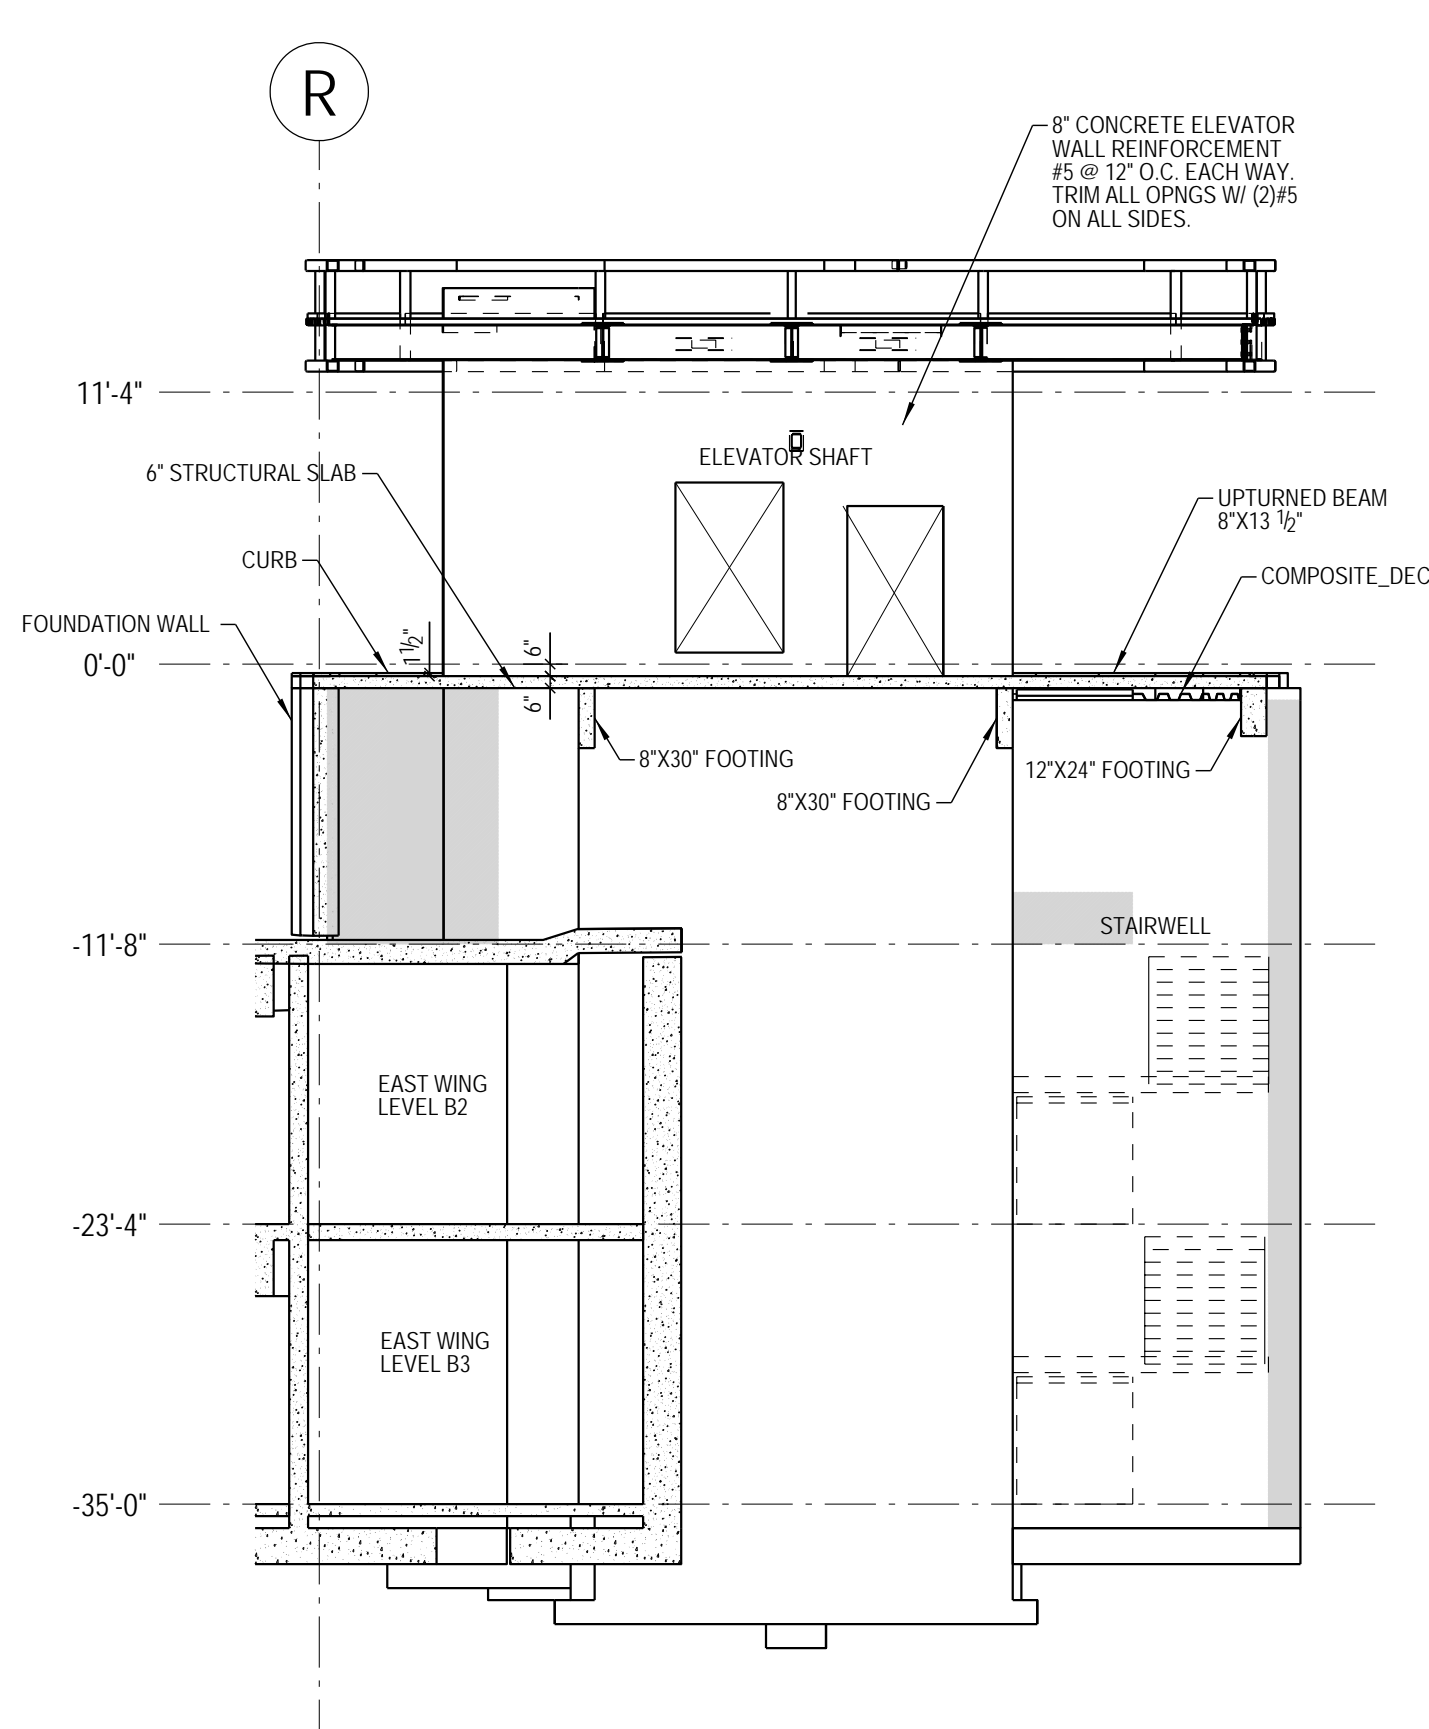


C4 ELEVATION @ STAIRWELL SOUTH SIDE
SCALE = 1/8"

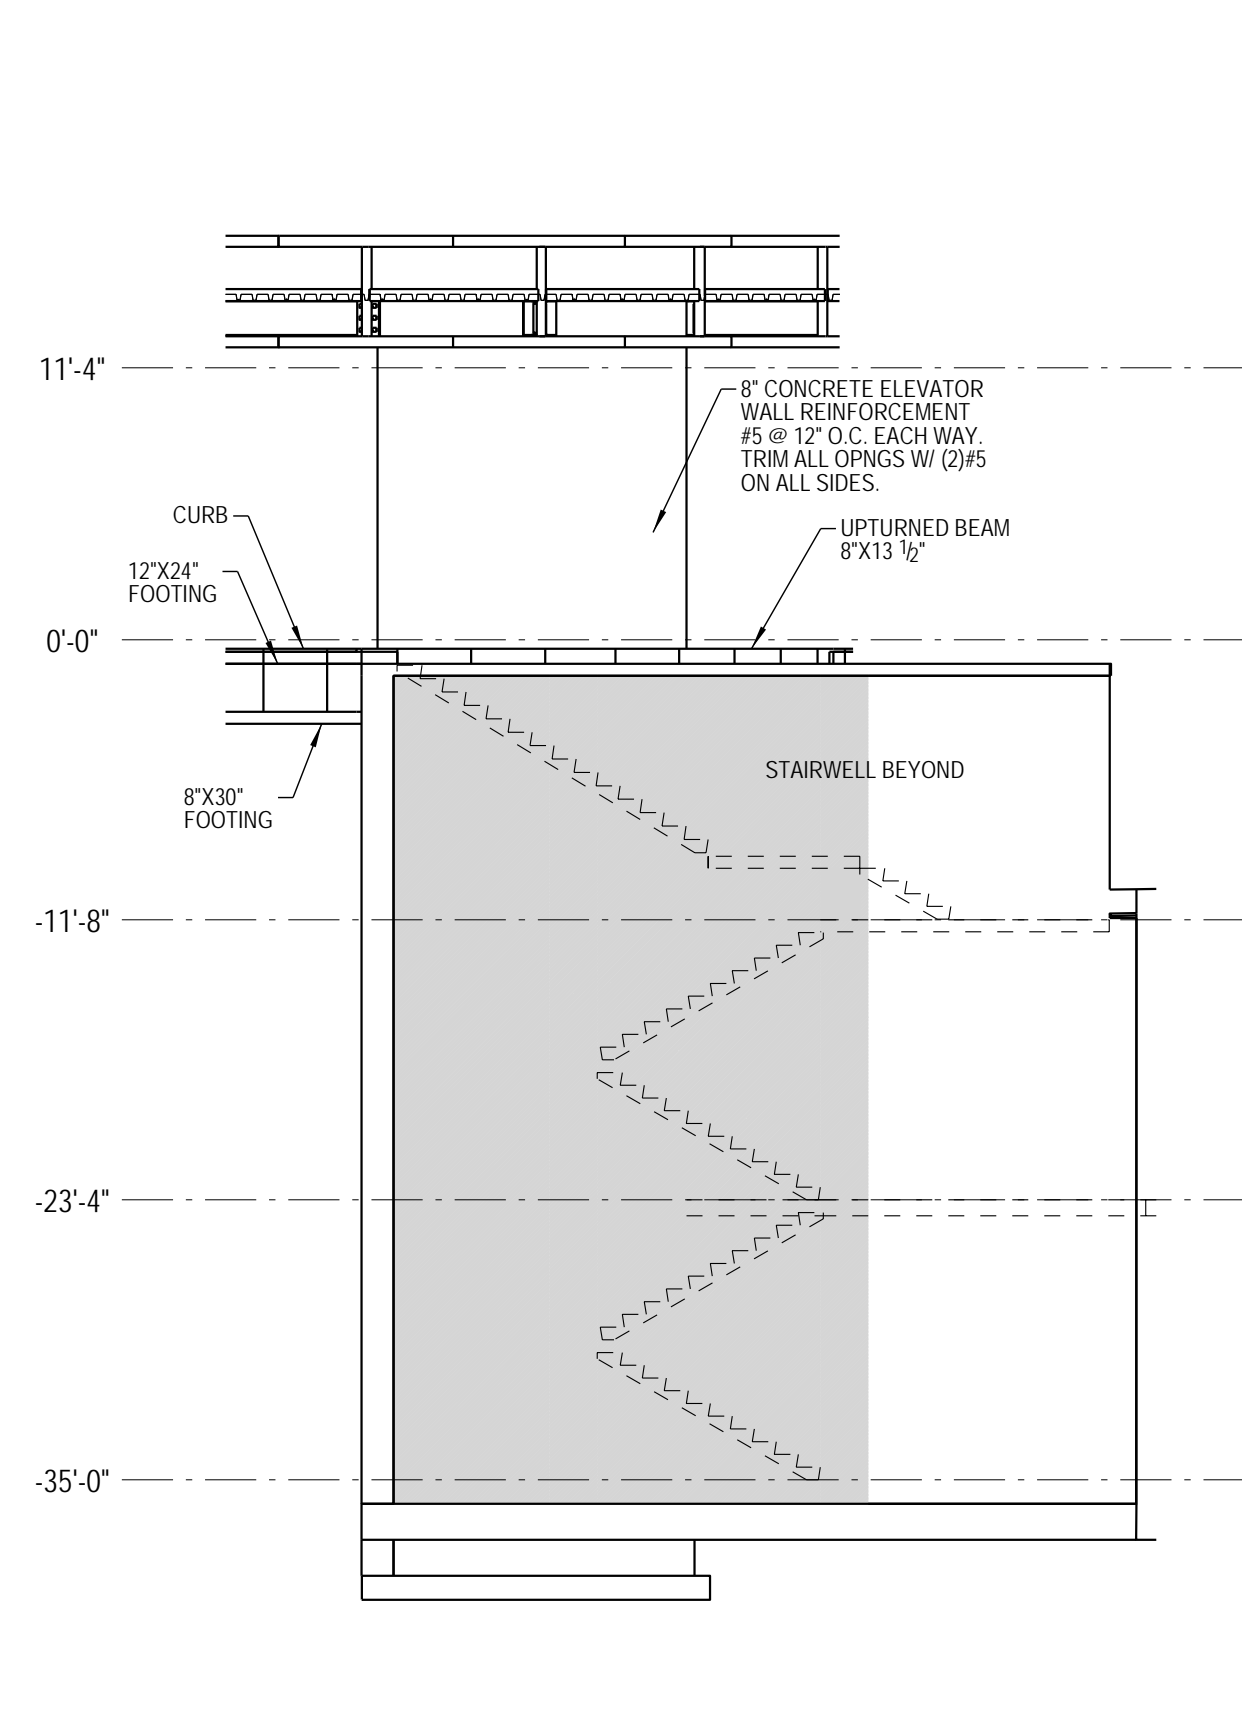


C6 ELEVATION @ STAIRWELL EAST SIDE
SCALE = 1/8"

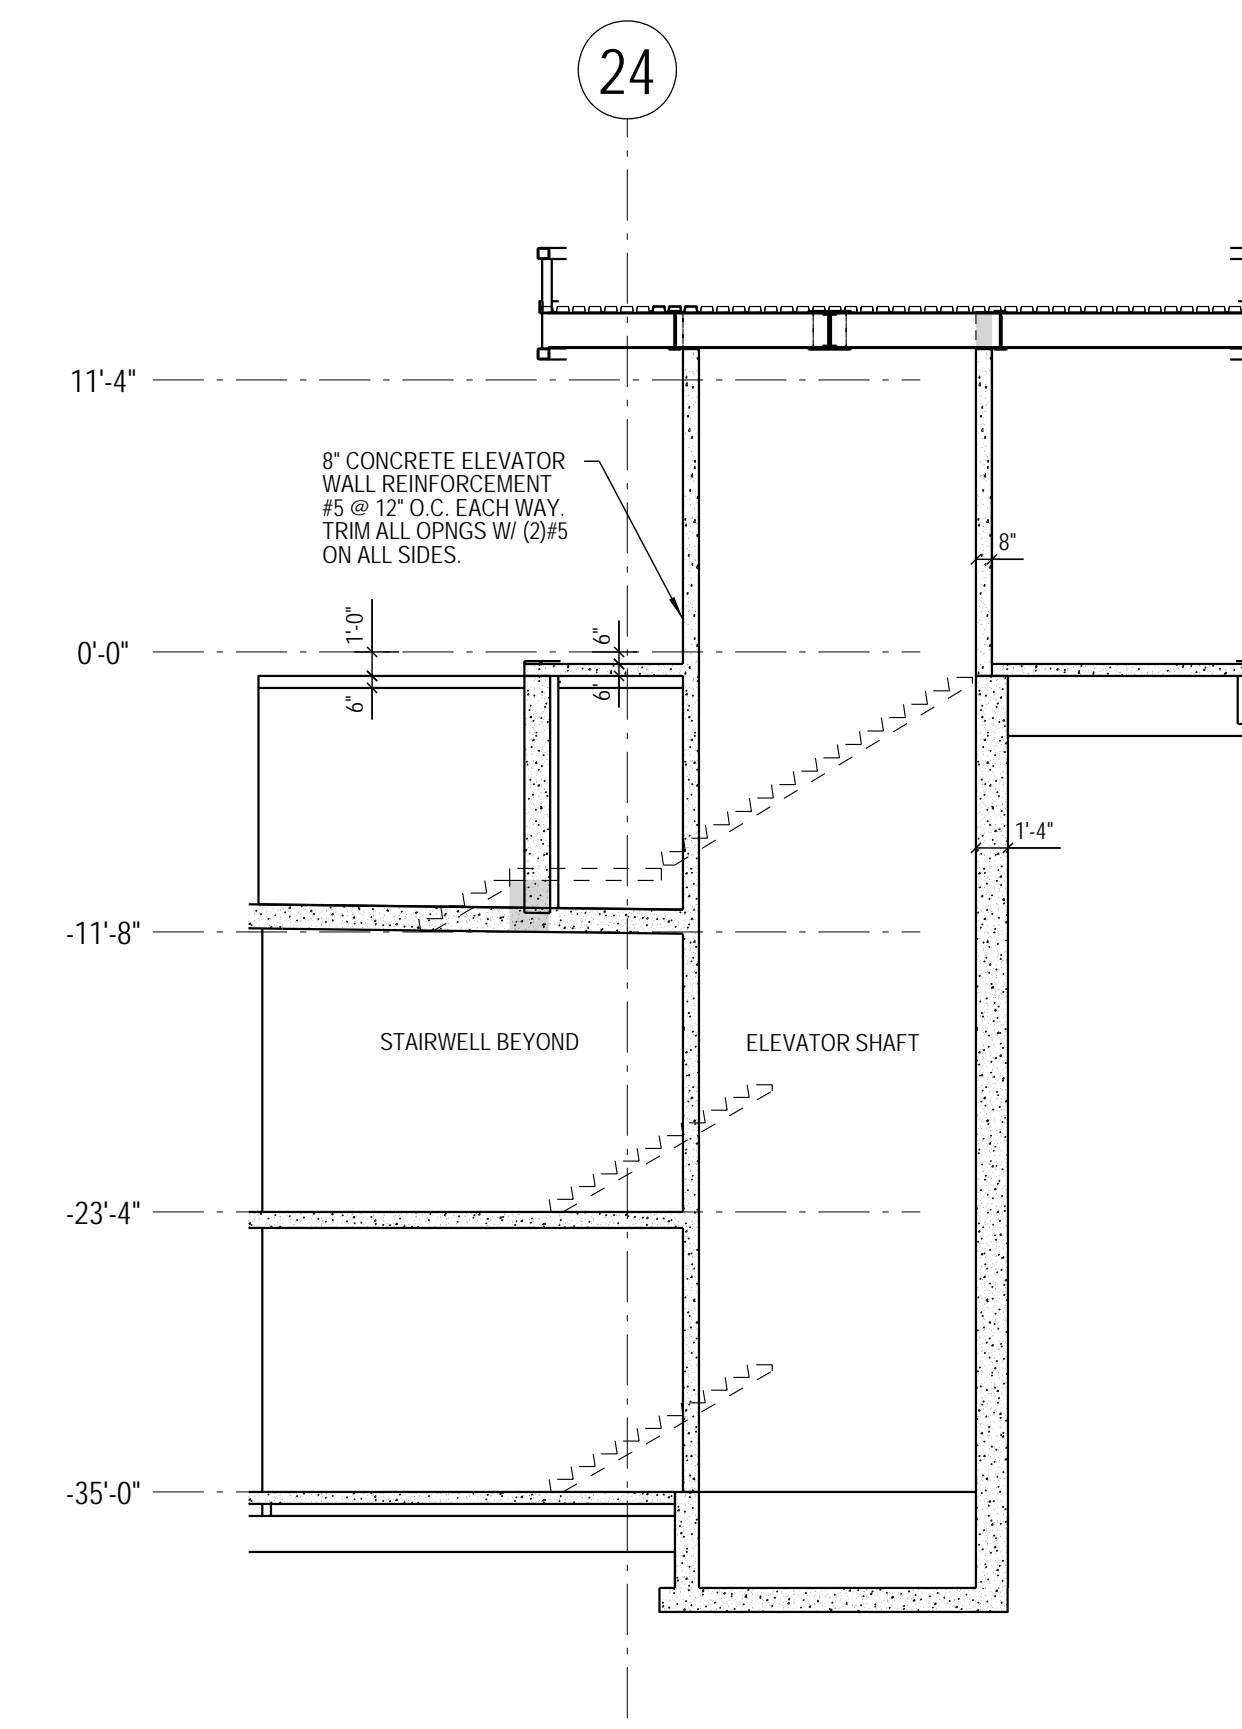


C8 ELEVATION @ STAIRWELL WEST SIDE
SCALE = 1/8"

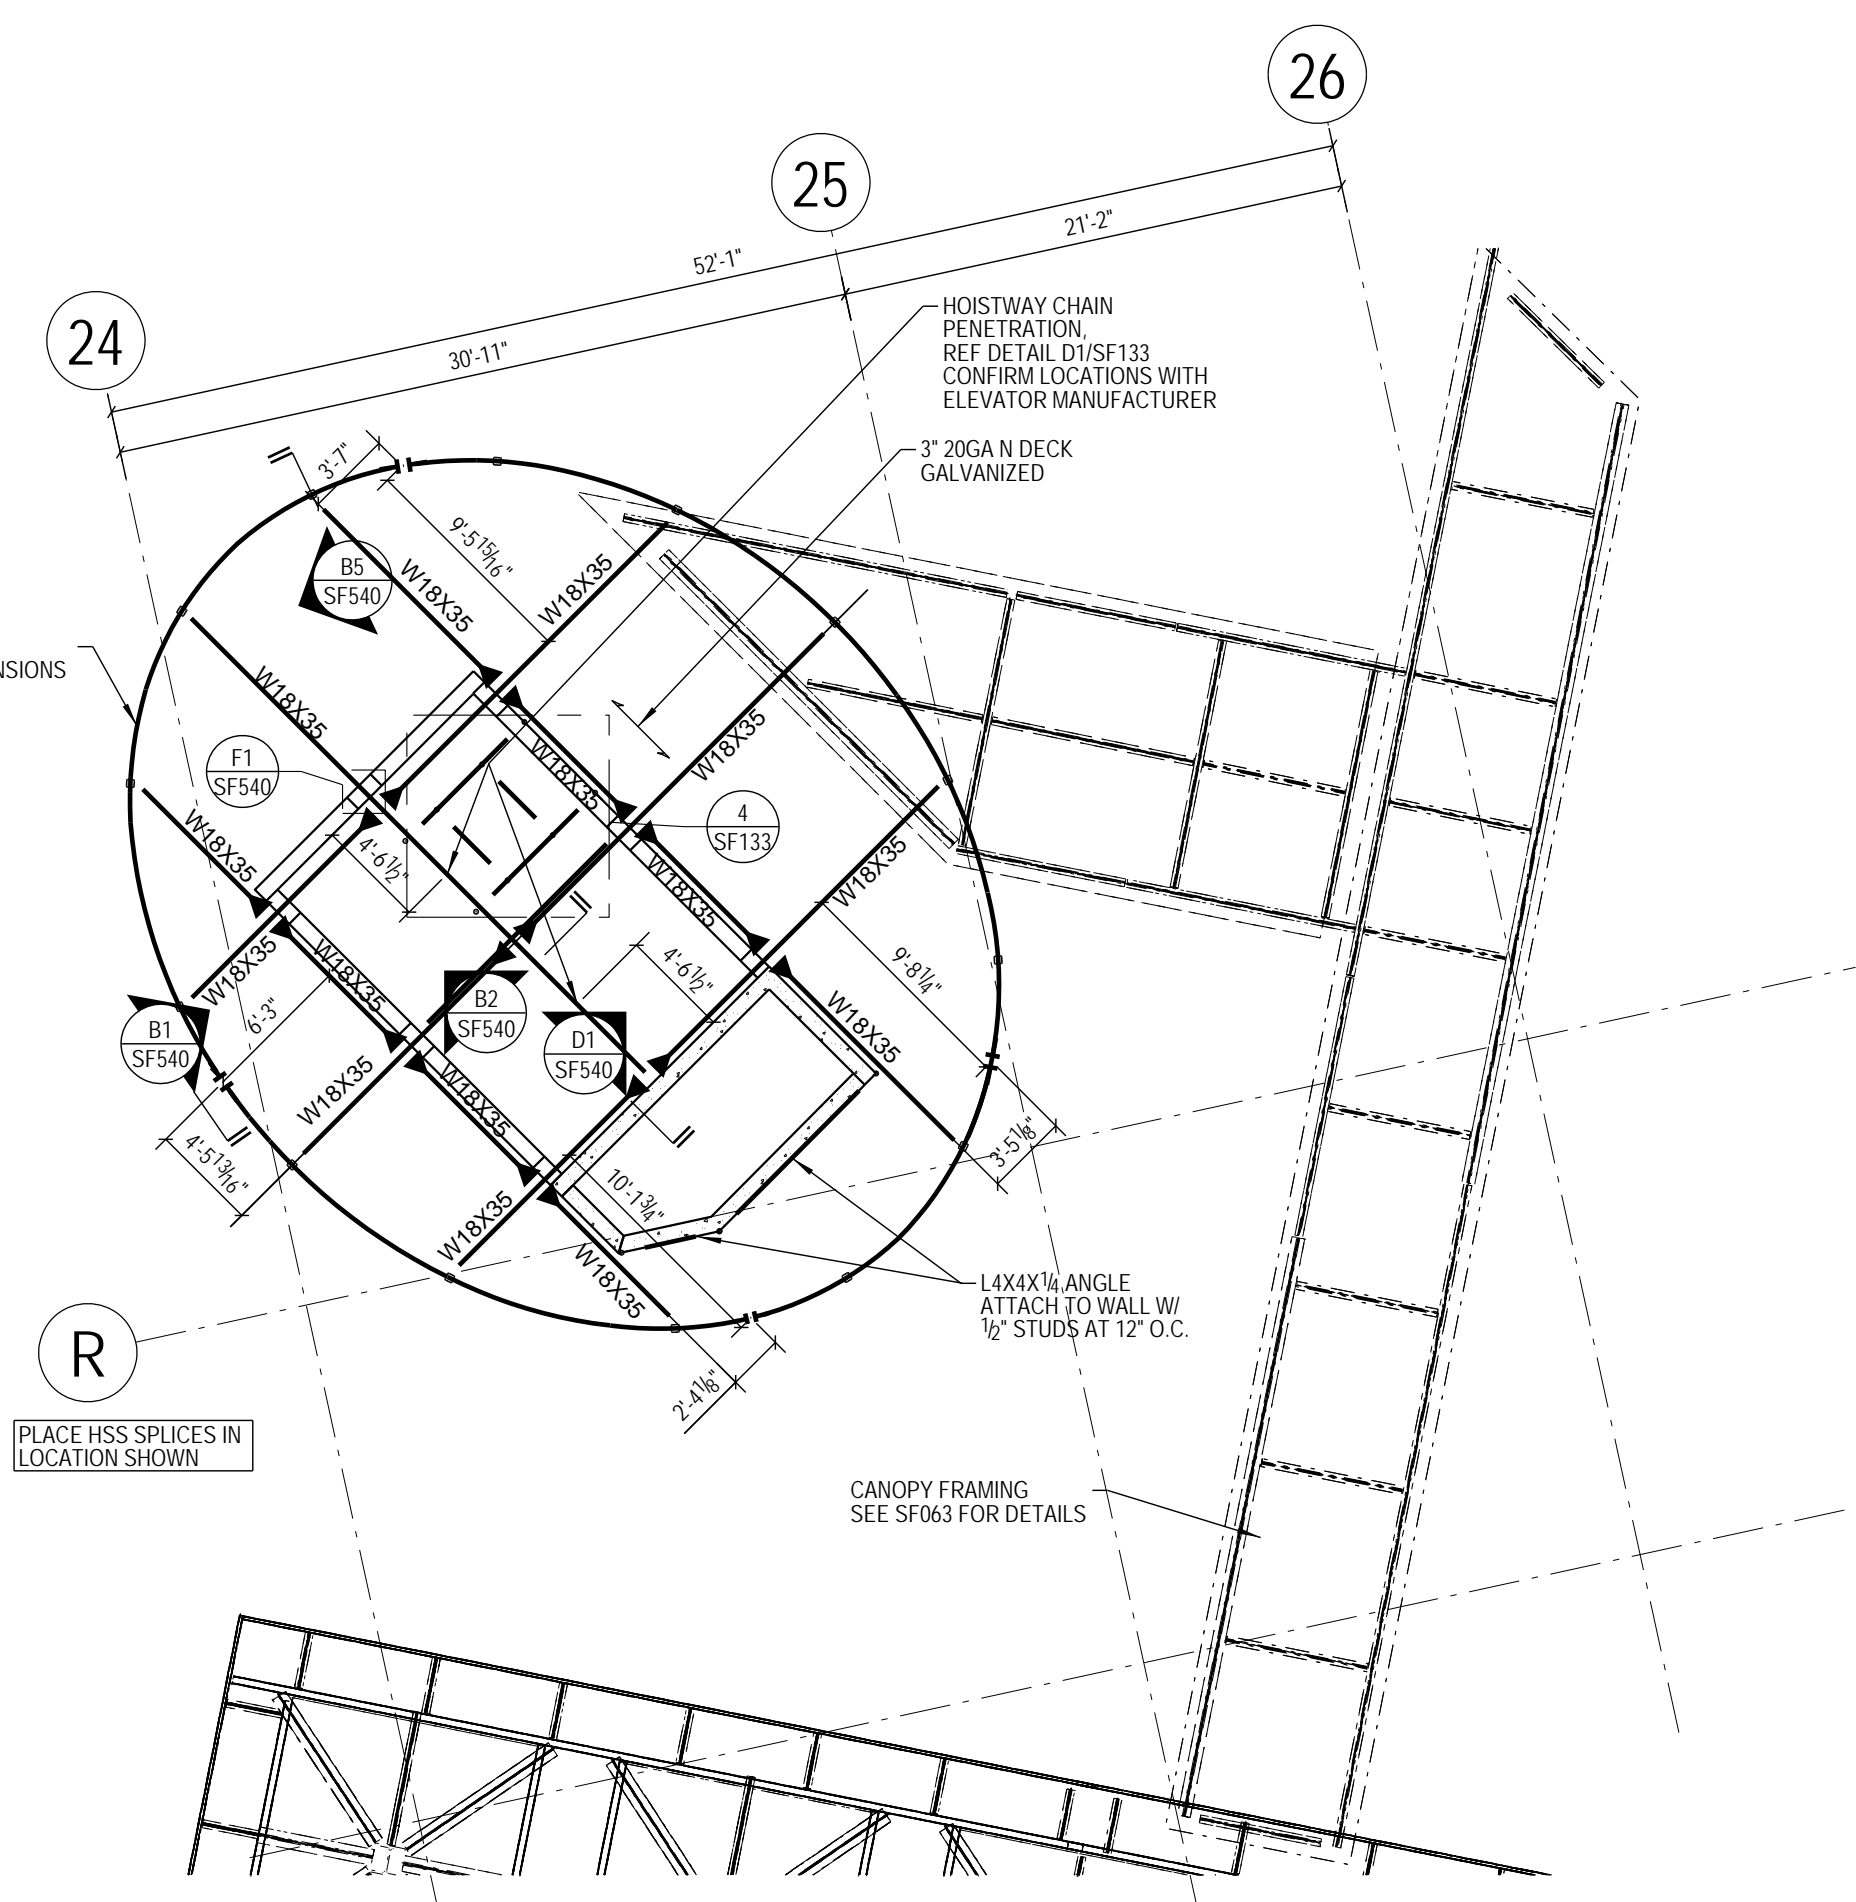

F1 PARTIAL LEVEL 2 FRAMING PLAN
SCALE: 1/8" = 1'-0"

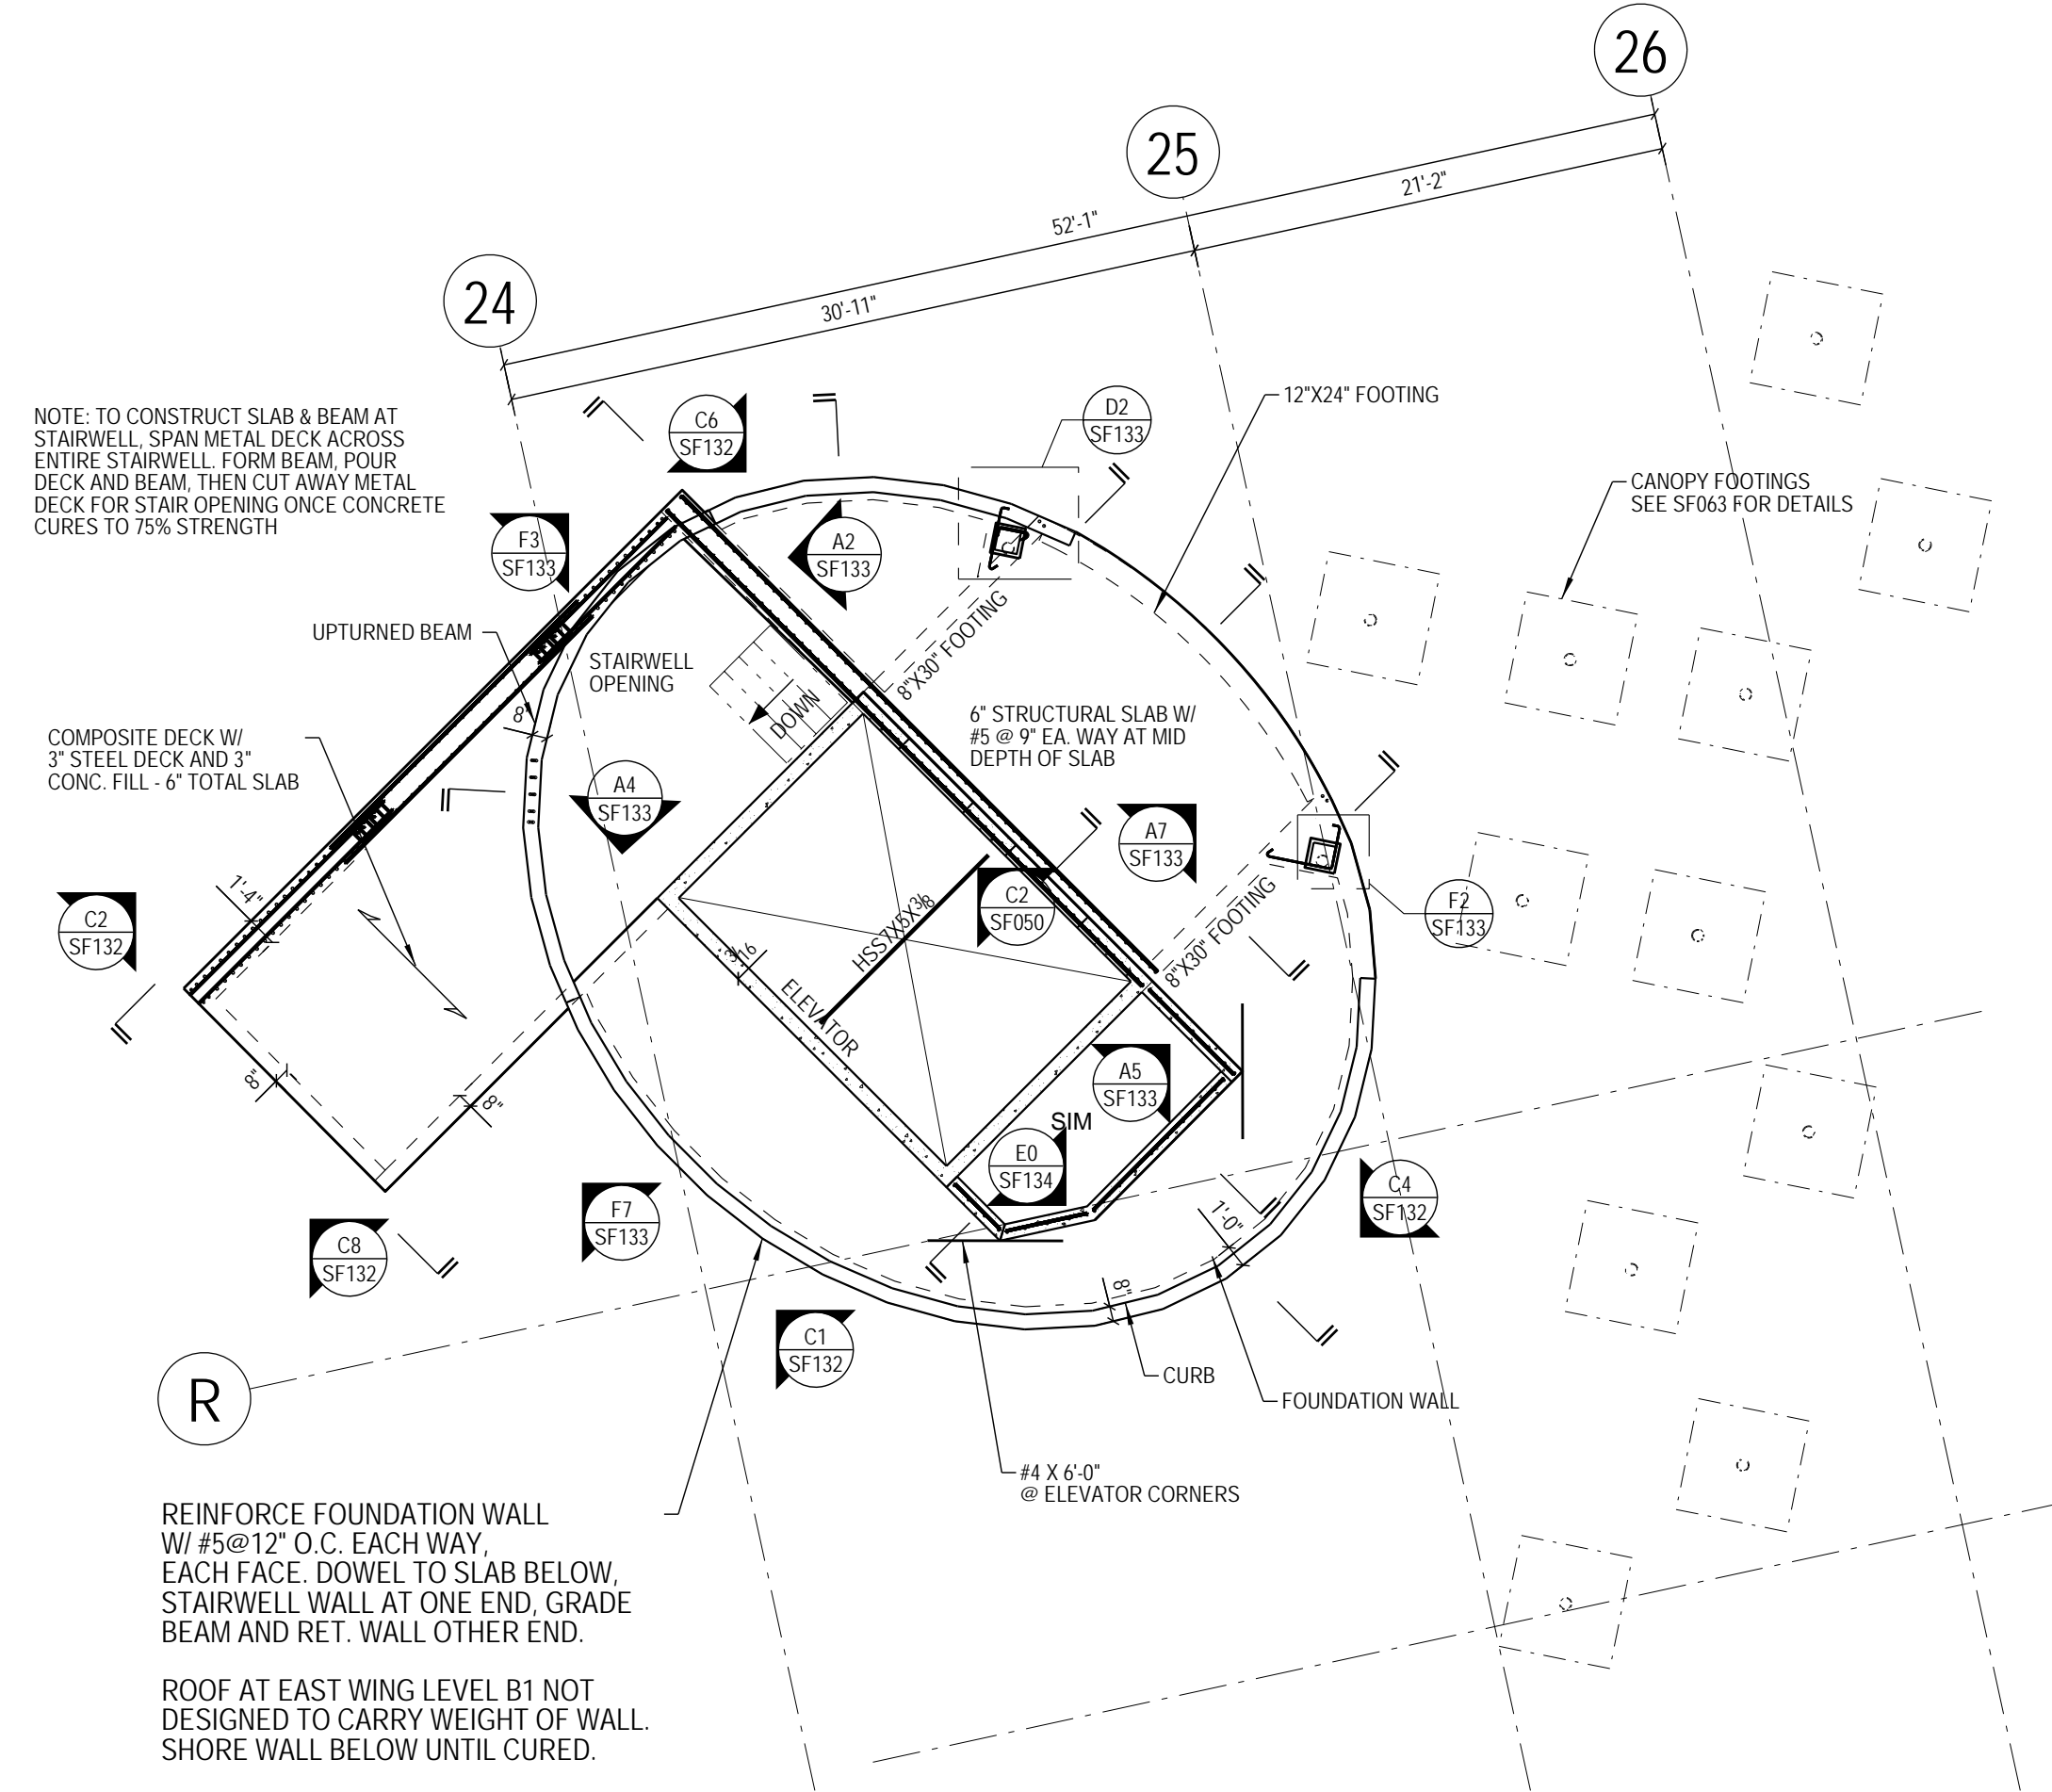

F4 PARTIAL LEVEL 1 FRAMING PLAN
SCALE: 1/8" = 1'-0"

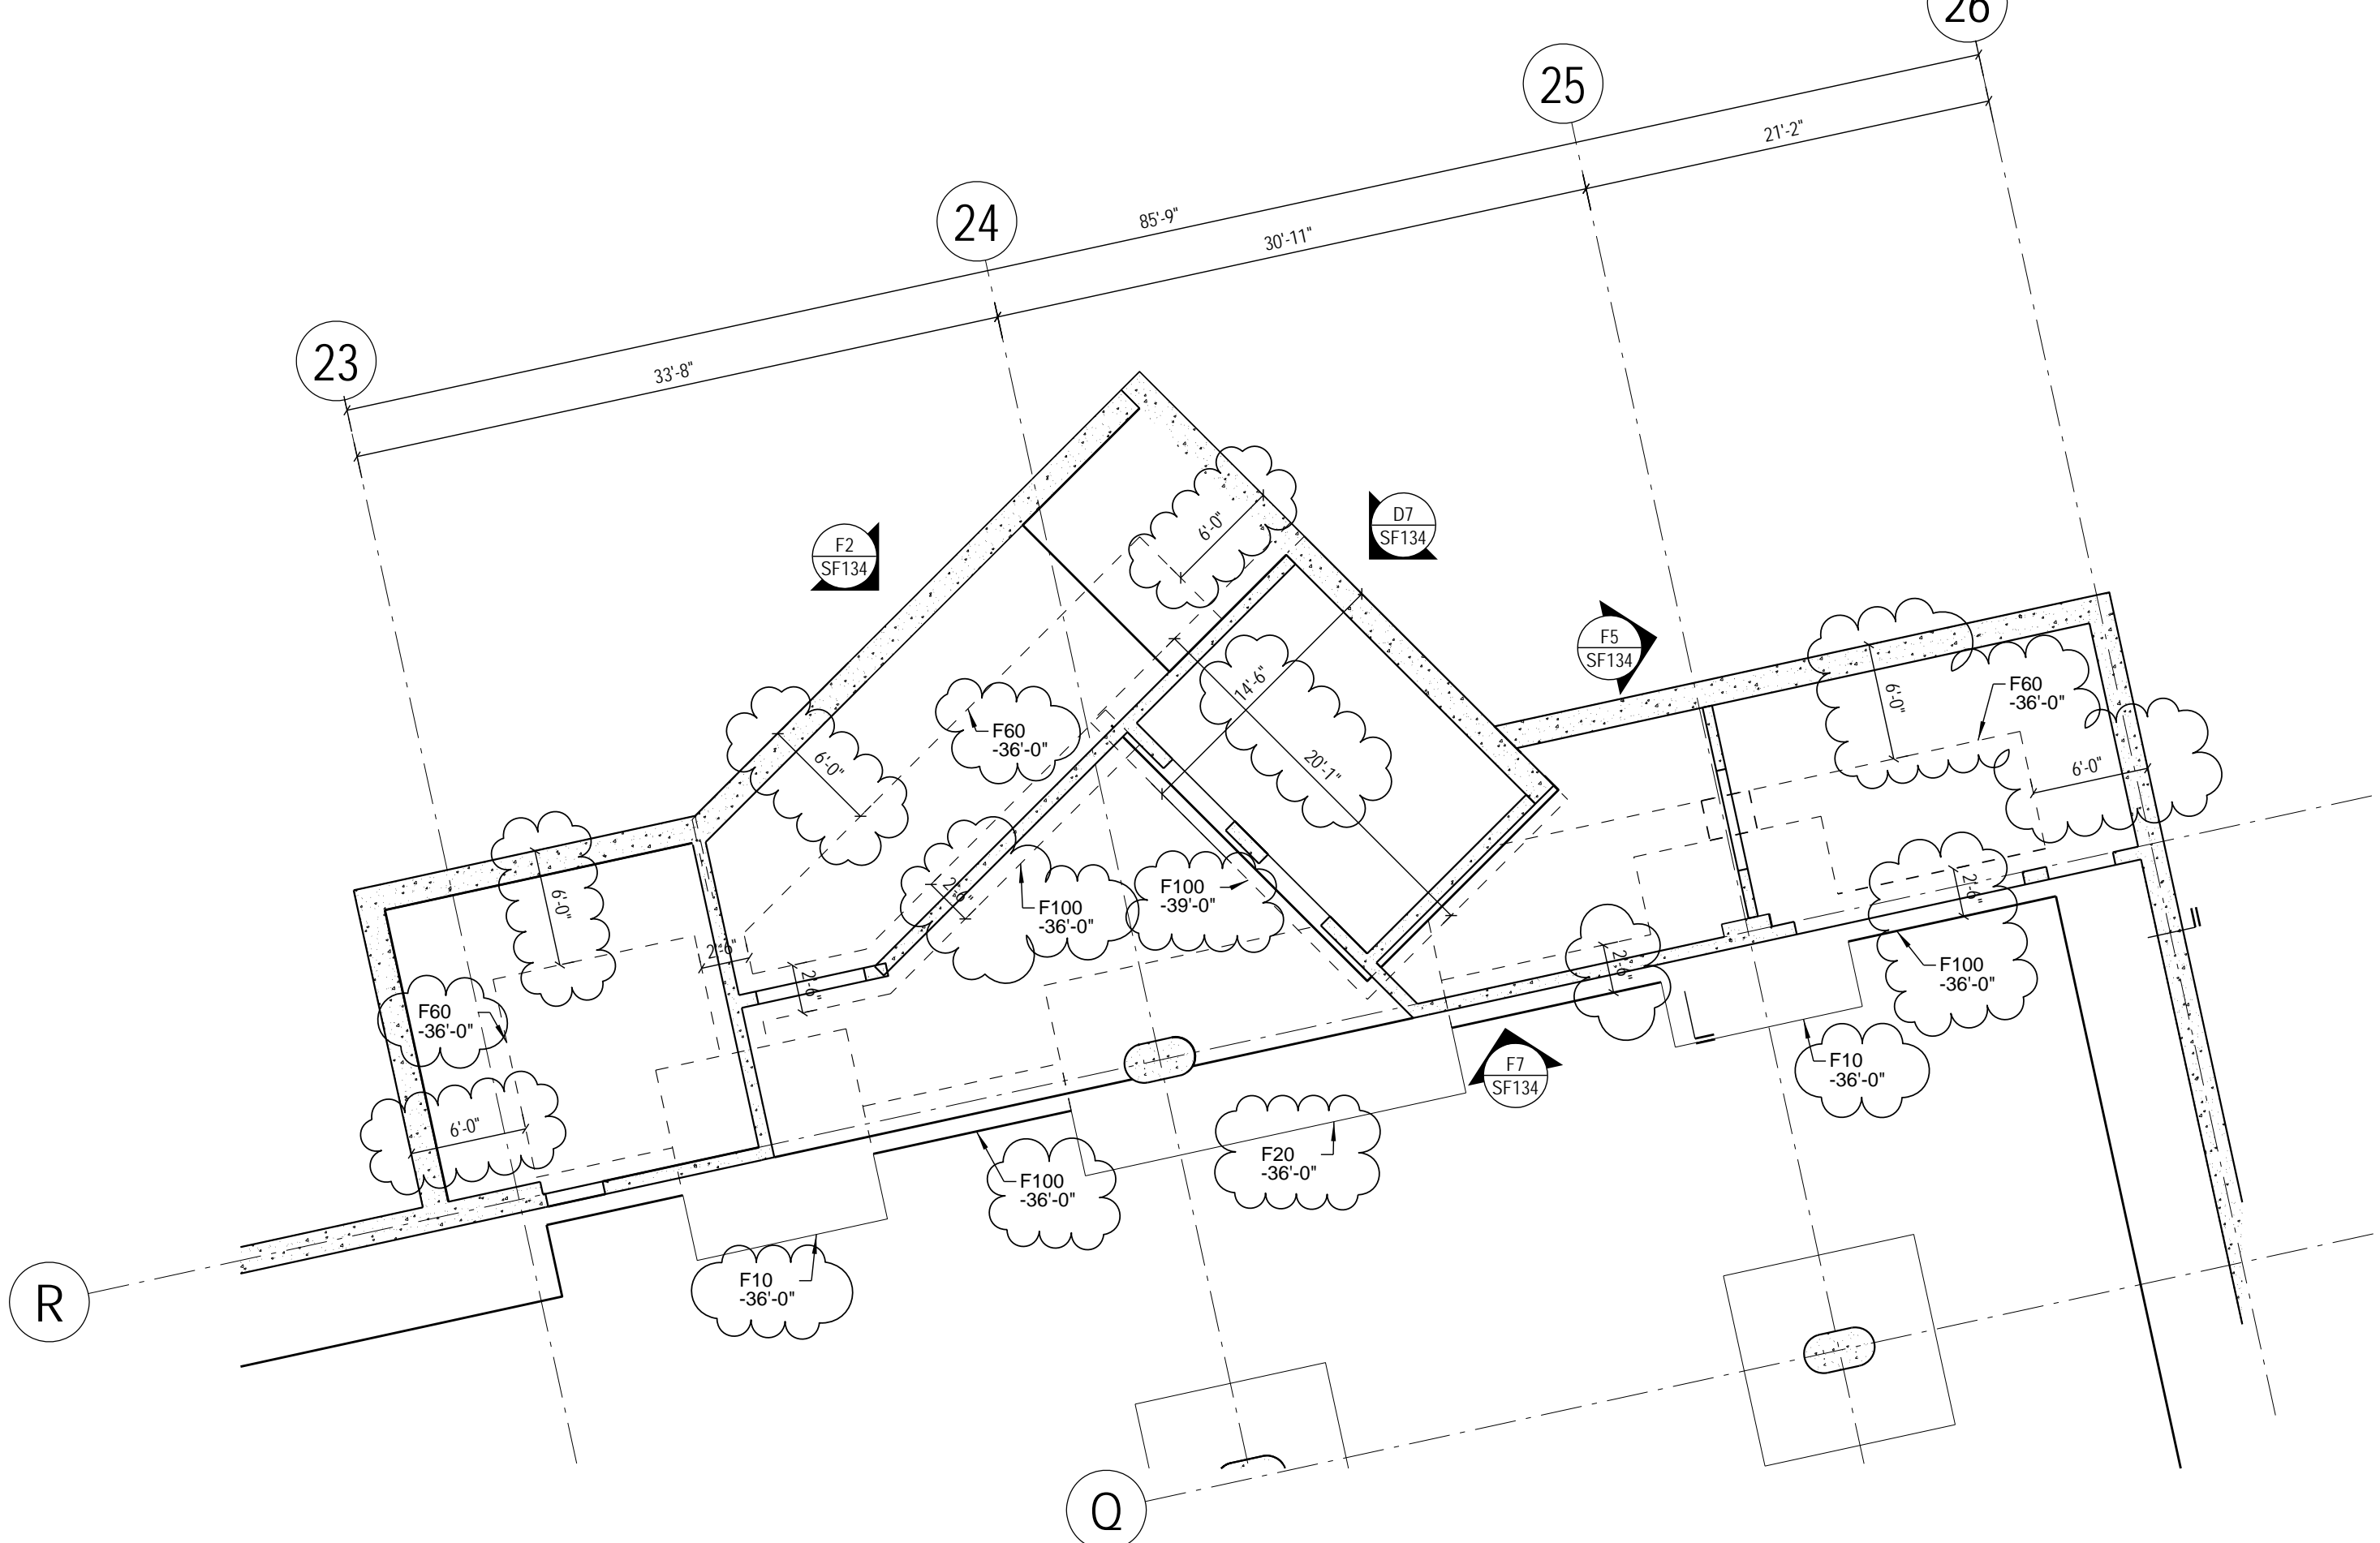


F7 PARTIAL FOUNDATION PLAN
SCALE = 1/8"

ADDENDUM	09.04.2013
CONSTRUCTION DOCUMENTS - CD2	05.10.2013
Revisions:	Date

CONSULTANTS:

Degenkolb
DEGENKOLB ENGINEERS
235 Montgomery Street, Suite 500
San Francisco, CA 94104
415.392.6592 Phone
415.981.3157 Fax
www.degenkolb.com
Project No. A0508005.00

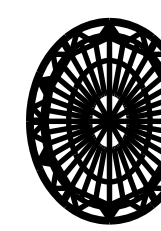

Gregory P. Luth & Associates, Inc.
Structural Engineers and Builders
2350 Scott Blvd, Bldg 40
Santa Clara, CA 95054
Telephone: 408.654-0475
Fax: 408.654-0475
www.gpalinc.com



ARCHITECT

STANTEC | THE DESIGN PARTNERSHIP
Structural Engineers and Builders
No. 52718
Exp. 12/31/2015

Drawing Title PARKING STRUCTURE - LEVEL B1 EAST WING ELEVATOR DETAILS	Drawing Scale As indicated	Approved: Project Director
---	-------------------------------	----------------------------

Project Title Parking Structure and Entry drive VAPSHCS Seattle Division- Phase 1 PARKING STRUCTURE AND ENTRY SITE	Location 1660 South Columbian Way, Seattle, WA 98105	Date JUNE 05, 2013
Project Number VAP663-405A	Building Number	Checked
Drawing Number VOL. 2 SF132	Drawn	

CONSTRUCTION DOCUMENT 2
FULLY SPRINKLERED

Office of
Construction and Facilities
Management
Department of
Veterans Affairs