




three inches = one foot  
one and one half inches = one foot  
one inch = one foot  
three quarter inch = one foot  
one half inch = one foot  
three eighth inch = one foot  
one eighth inch = one foot  
one eighth inch = one foot

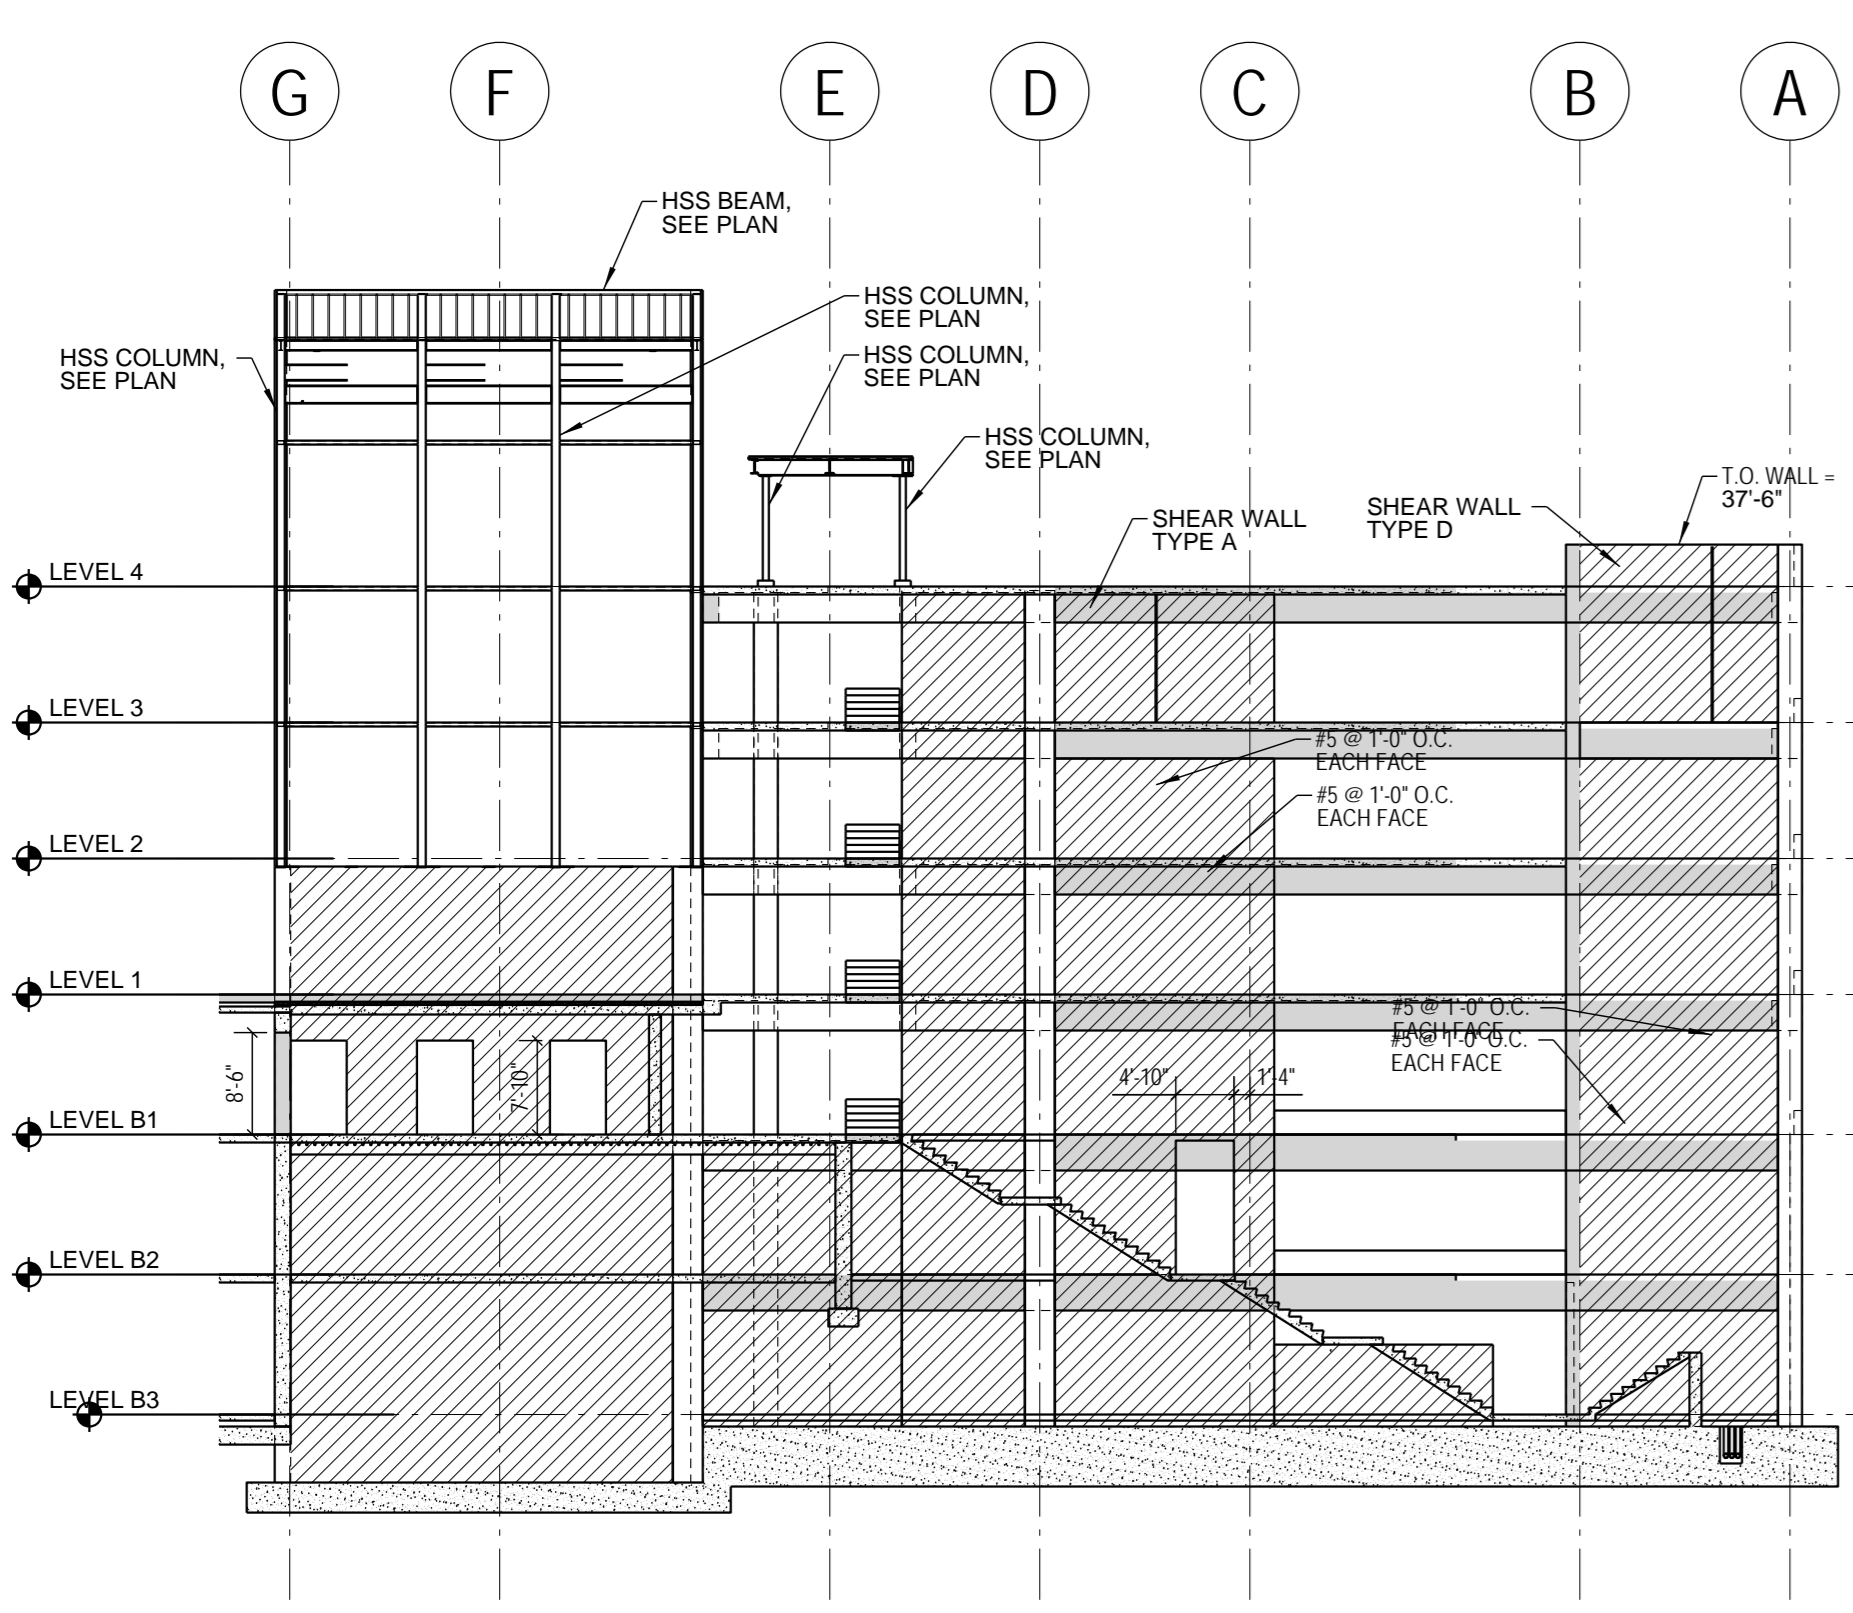


Q SECTION  
SCALE = 1:192

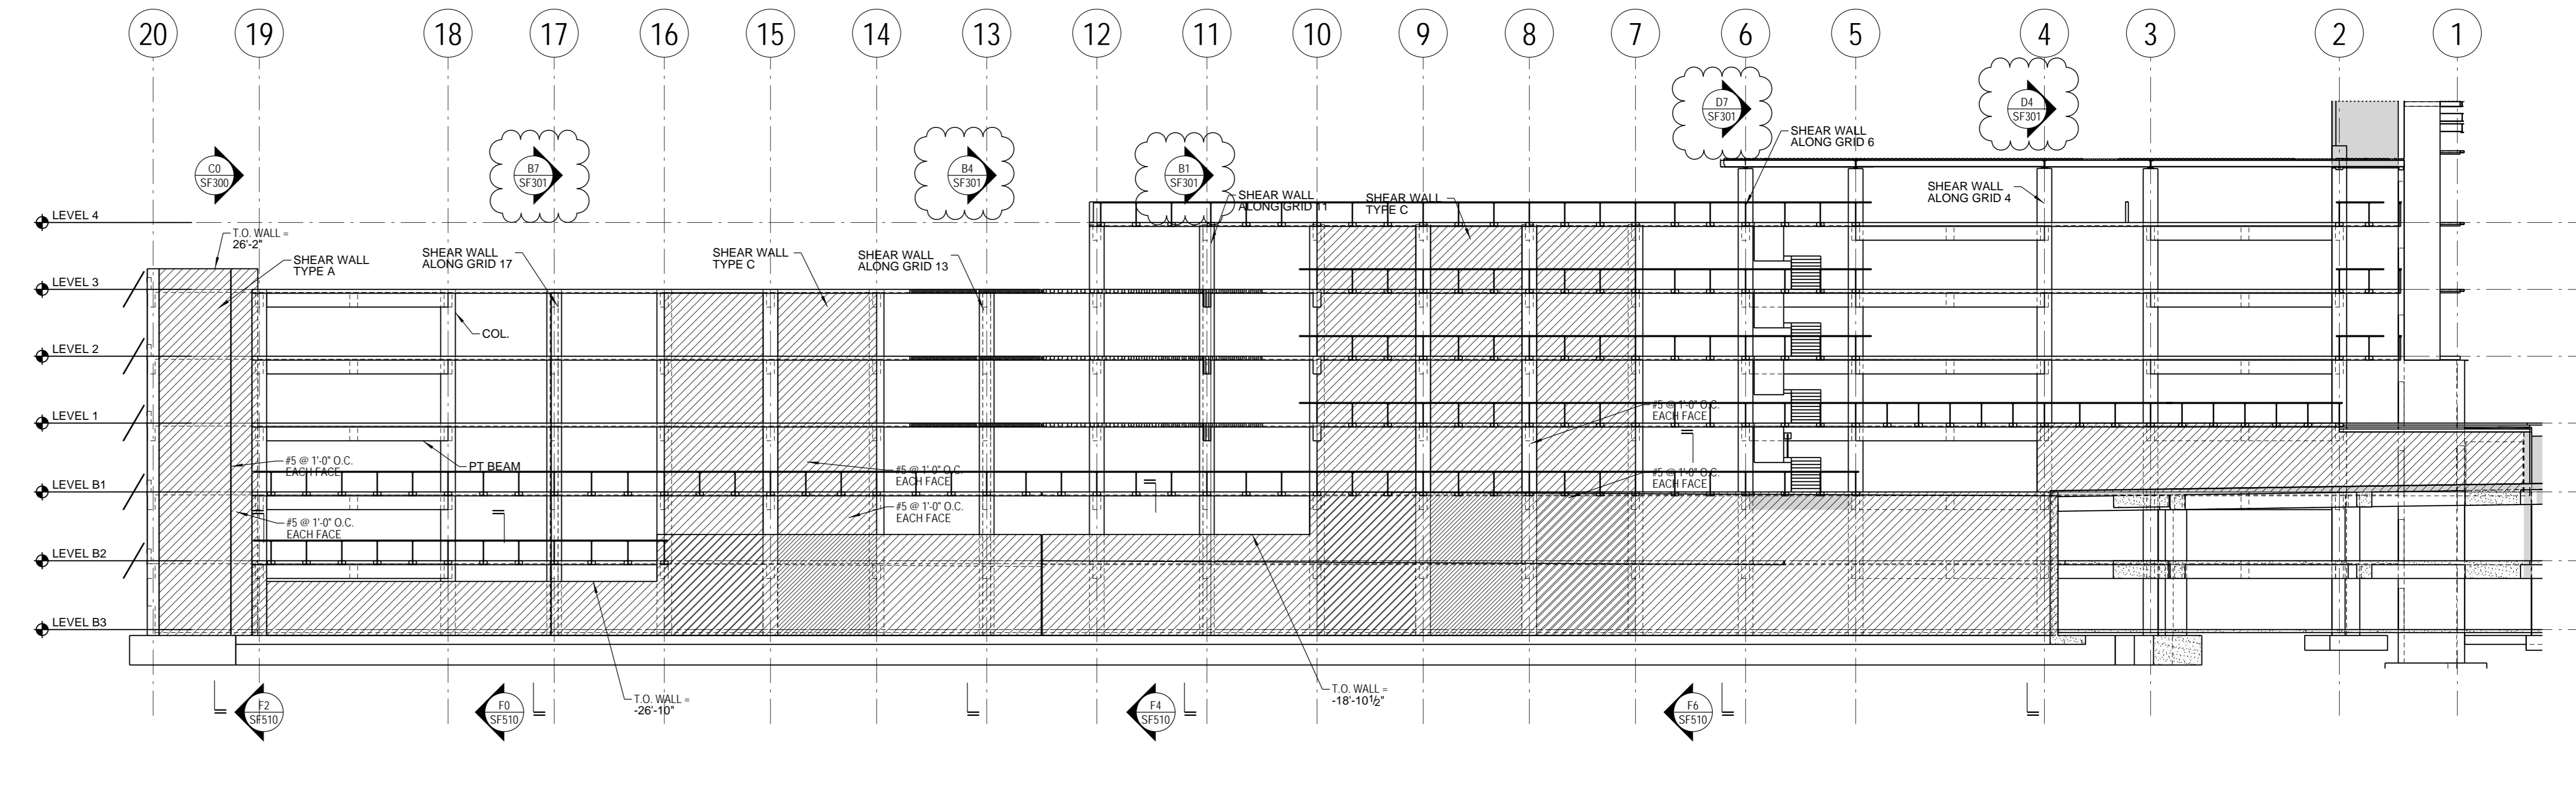

C3 WALL ELEVATION ON GRID H  
SCALE = 1:192

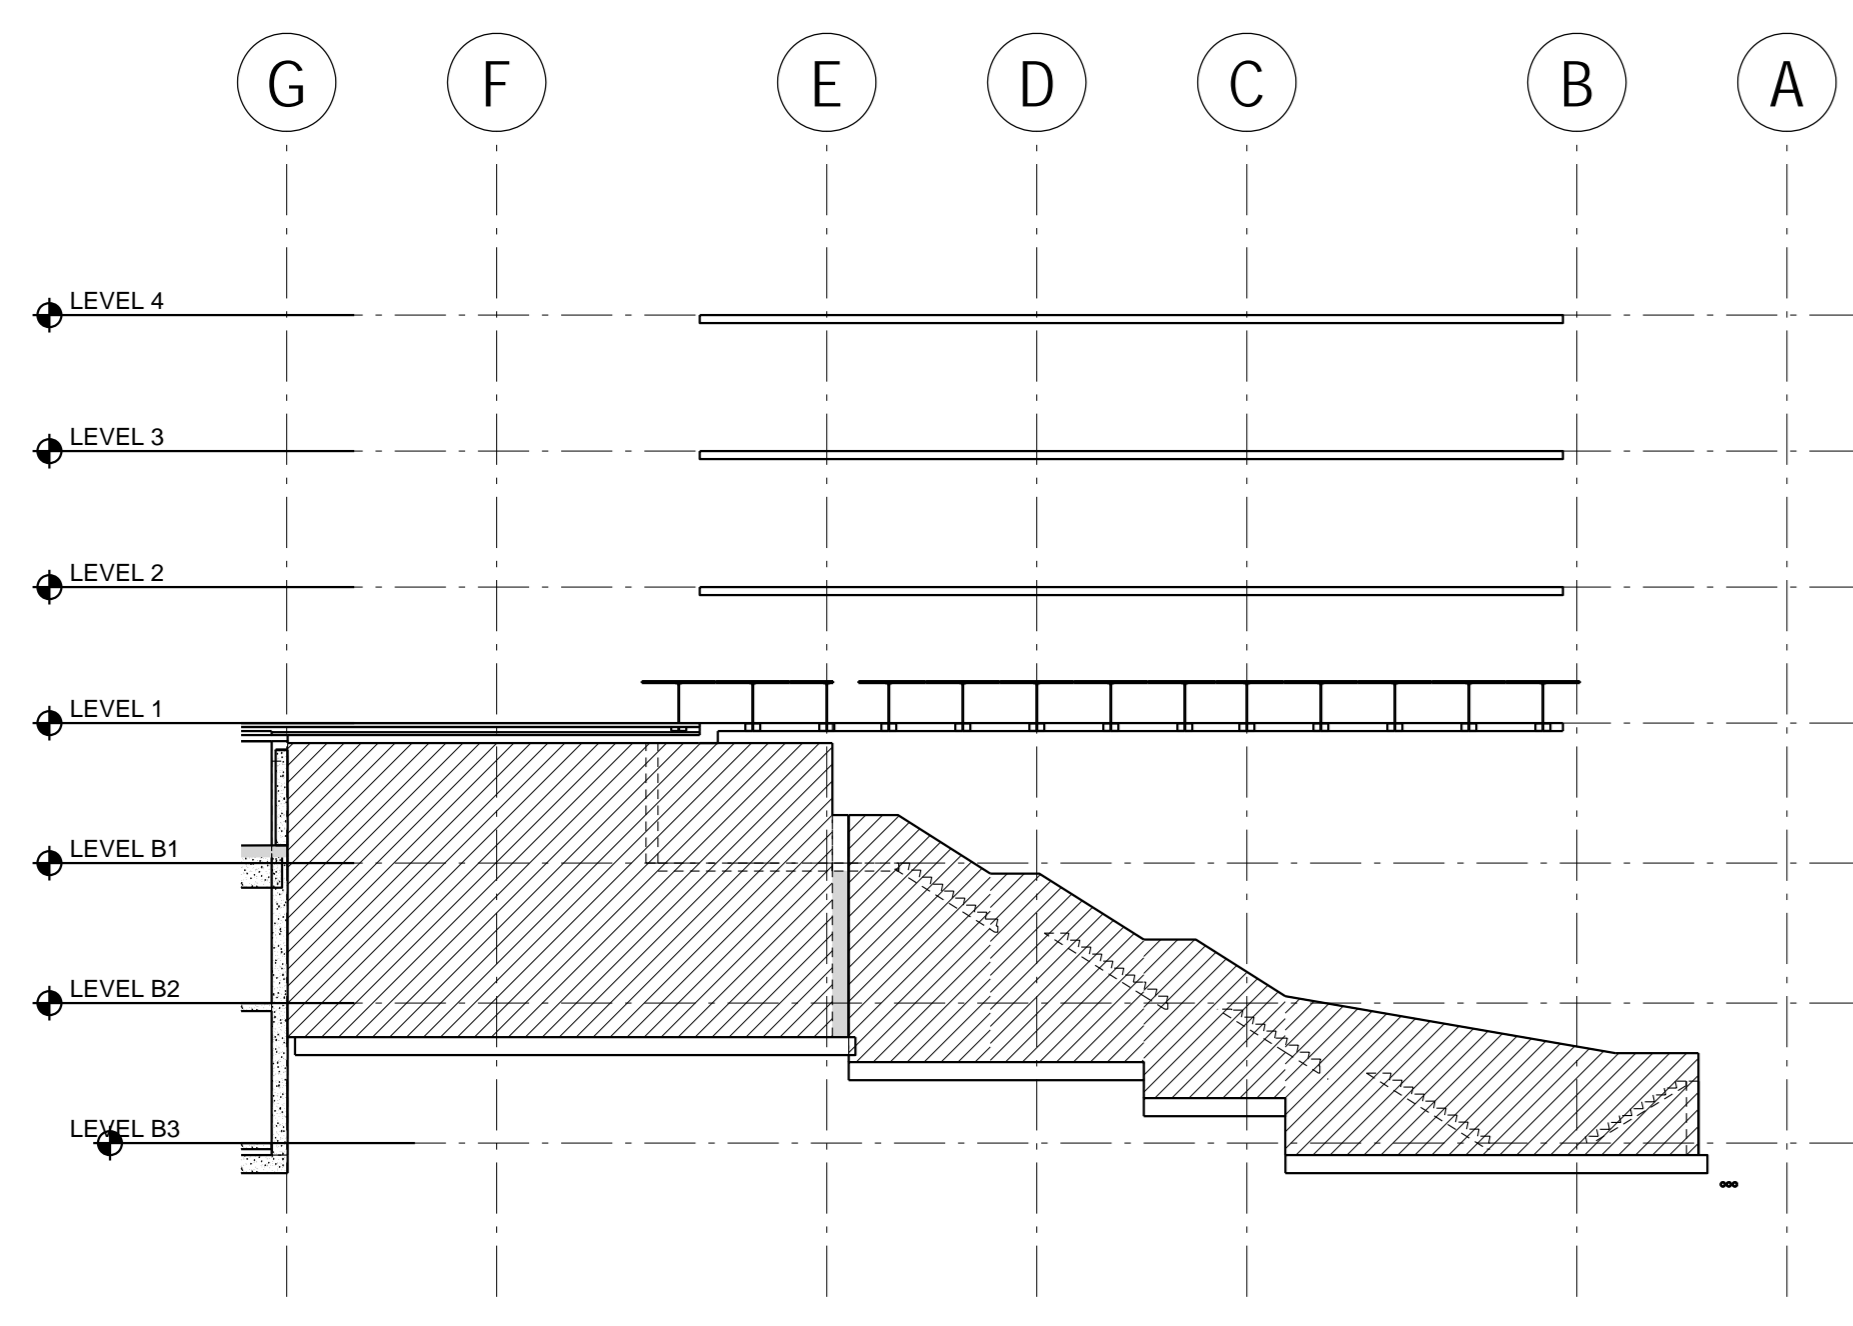

F0 WALL ELEVATION ON GRID 1  
SCALE = 1:192

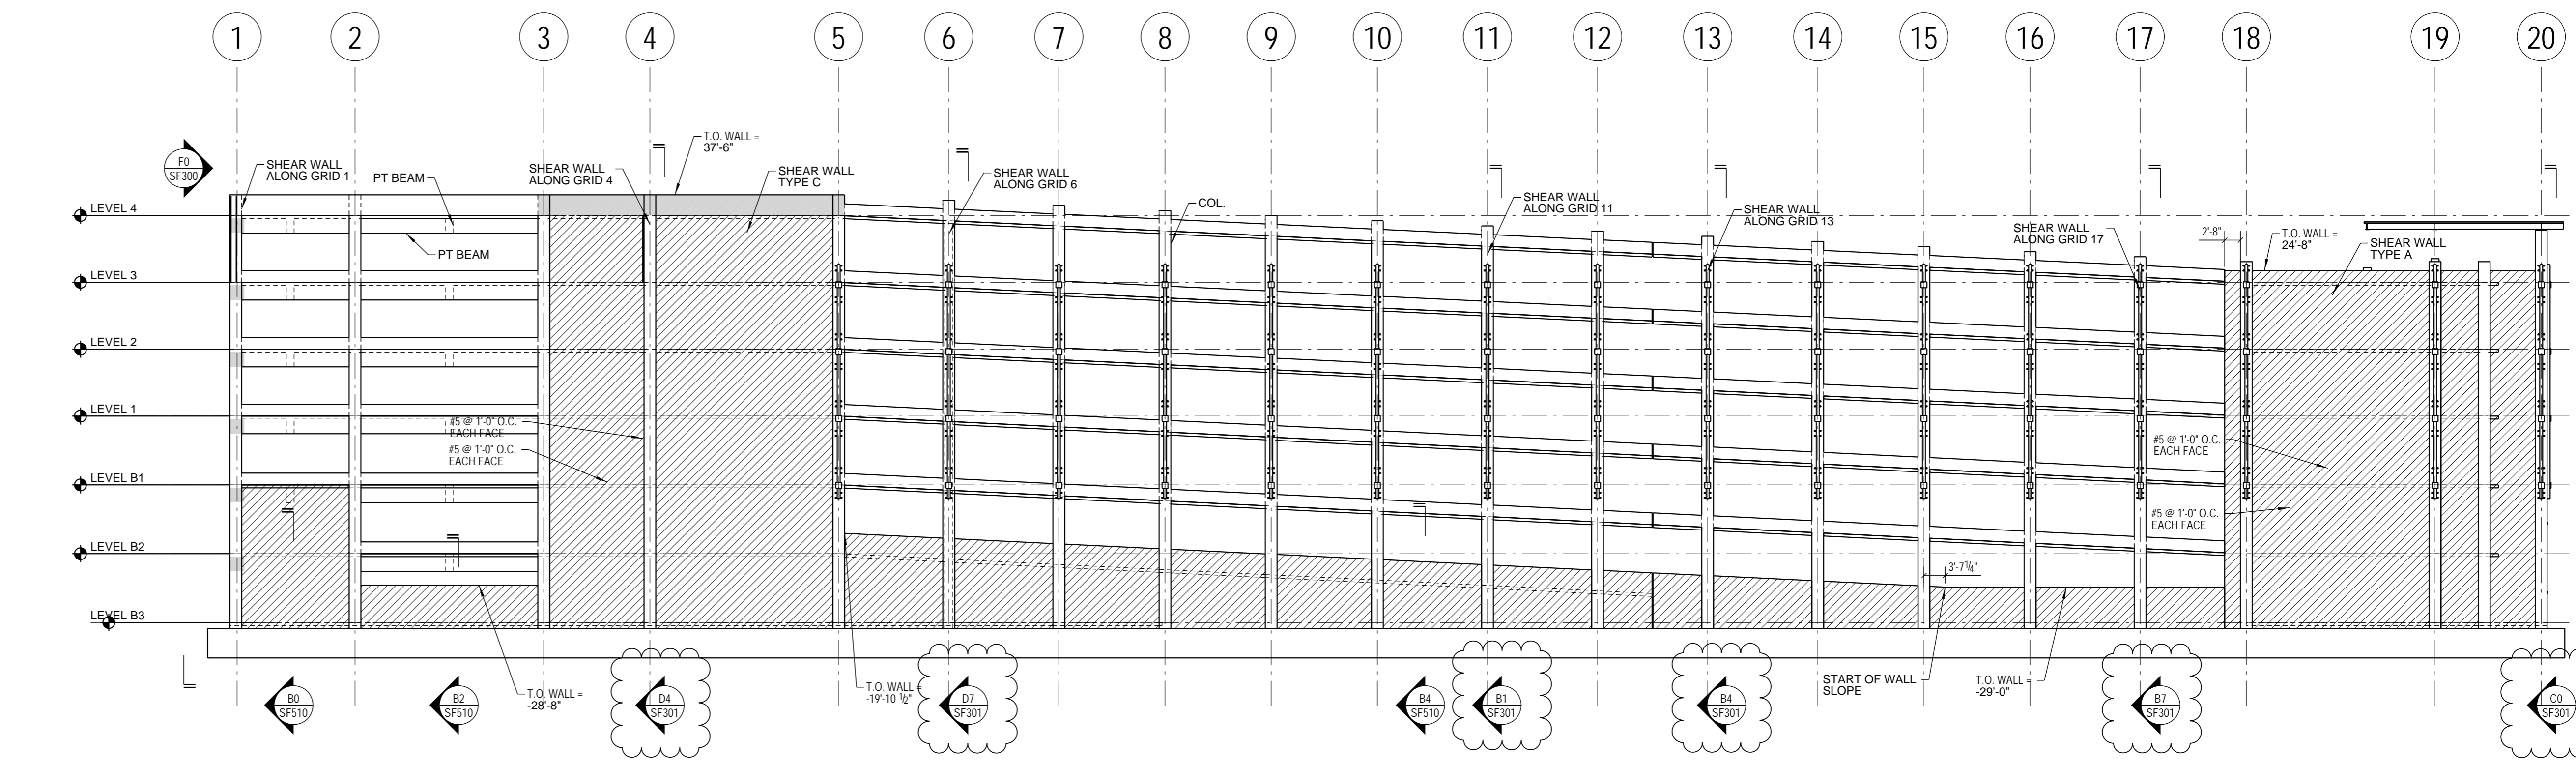

F3 WALL ELEVATION ON GRID A  
SCALE = 1:192

ADDENDUM	09.04.2013
CONSTRUCTION DOCUMENTS-CD2	05.10.2013
Revisions:	Date

**CONSULTANTS:**

**Degenkolb**  
DEGENKOLB ENGINEERS  
235 Montgomery Street, Suite 500  
San Francisco, CA 94104  
415.392.6562 Phone  
415.981.3157 Fax  
www.degenkolb.com  
Project No. A6598005.00

**Gregory P. Luth & Associates, Inc.**  
Structural Engineers and Builders  
3300 Scott Blvd, Bldg 48  
Santa Clara, CA 95054  
Telephone: 408.654.0475  
Fax: 408.654.0475  
www.gpalinc.com

**ARCHITECT**

**STANTEC | THE DESIGN PARTNERSHIP**

<b>Drawing Title</b> PARKING STRUCTURE - WALL ELEVATIONS	<b>Project Title</b> Parking Structure and Entry drive VAPSHCS Seattle Division- Phase 1 PARKING STRUCTURE AND ENTRY SITE	<b>Project Number</b> VAH663-405A	<b>Office of Construction and Facilities Management</b> 
<b>Drawing Scale</b> As indicated	<b>Location</b> 1660 South Columbian Way, Seattle, WA 98105	<b>Building Number</b>	
<b>Approved:</b> Project Director	<b>Date</b> JUNE 05, 2013	<b>Drawing Number</b> VOL. 2 SF300	

CONSTRUCTION DOCUMENT 2  
FULLY SPRINKLERED