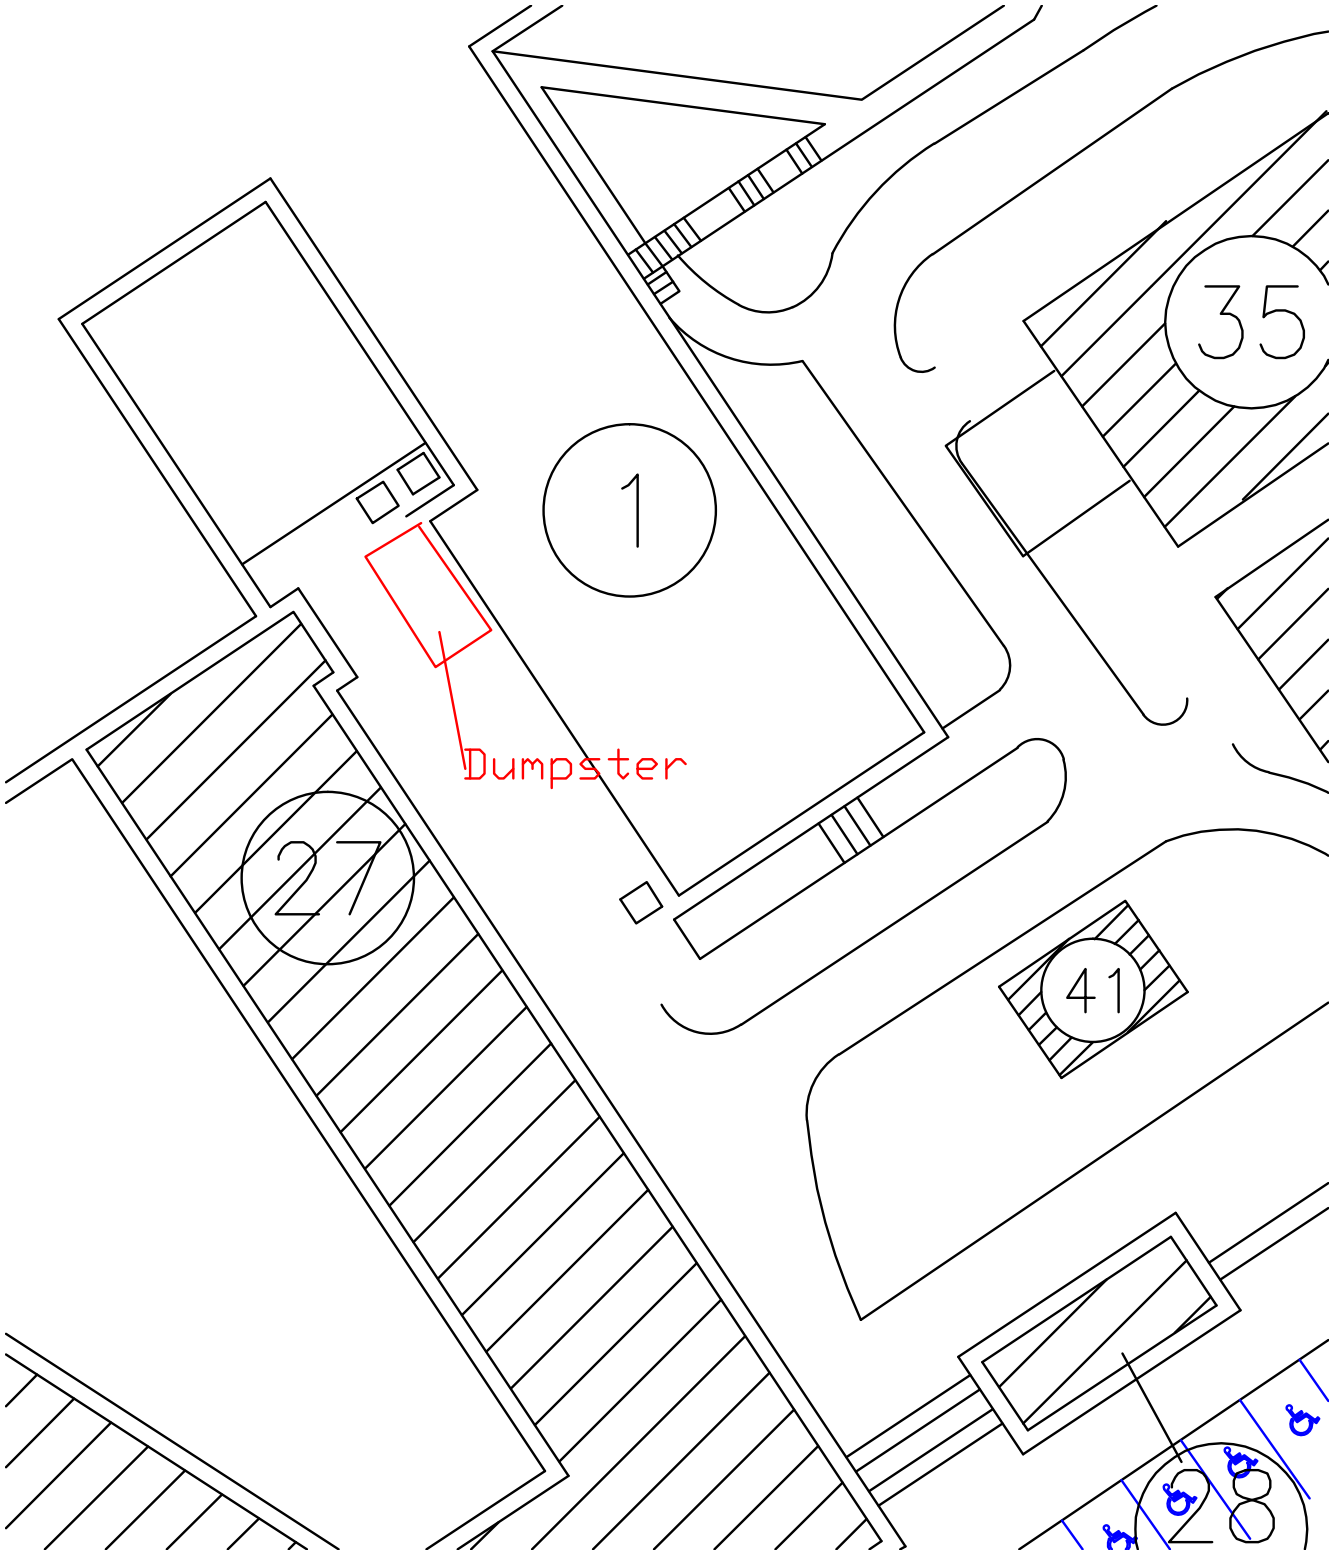
1
35
27
41
28
Dumpster